

MISSISSIPPI DEPARTMENT OF ENVIRONMENTAL QUALITY

Office of Land and Water Resources

P. O. Box 10631
Jackson, MS 39289-0631
WATER WELL DRILLERS LOG

COUNTY WELL LOCATED <i>Marion</i>	
WELL NUMBER <i>Q 2092</i>	CODED
DATE WELL COMPLETED <i>2-16-96</i>	

PERMIT NUMBER <i>0-586</i>
NAME OF DRILLING FIRM <i>James Wells Water Well Ser.</i>

NAME & MAILING ADDRESS OF LANDOWNER <i>Virgie Hammond 197 St Paul Rd Sandy Hook Miss 39478</i>	
WELL LOCATION: SEC <i>6</i> TOWNSHIP <i>6</i> RANGE <i>14</i>	<i>N</i> <i>E</i> <i>S</i> <i>W</i>
DISTANCE <i>10</i> Miles DIRECTION <i>South</i> of NEAREST TOWN <i>Fox Woods</i>	
OTHER LANDMARK	
WELL PURPOSE: Home Irrigation, Municipal, Industrial, Fish Pond, etc.	

PUMP DATA		
PUMP TYPE (Circle One): Submersible, Turbine, <input checked="" type="radio"/> Jet, Flowing Well, Other (Describe) _____		
POWER TYPE (Circle One): <input checked="" type="radio"/> Electric, Tractor, Diesel, Gasoline, Butane, Other (Describe) _____ H/P _____		
Pump Capacity (GPM)	No. of Stages	Setting Depth FT.
PUMP TEST		
Well yielded _____ <i>8</i> GPM with a drawdown of _____ ft. after _____ hours of pumping		

WELL DATA		
Well Depth <i>30</i>	Casing Diameter (In.) <i>2 in</i>	Casing Length (Ft.) <i>22</i>
Type of Casing <i>PLC</i>	Hole Depth <i>30</i>	Depth to Static Water Level <i>8</i>

LOG DATA	
TYPE OF LOG RUN (Circle One): No Log Run, Electric, Gamma Ray, Density, Sonic, Neutron, Other (Describe) _____	
Name of Organization Running Log	

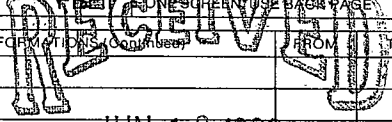
TYPE OF COMPLETION: (Circle One or More): <input checked="" type="checkbox"/> Gravel Packed, <input type="checkbox"/> Underreamed, <input type="checkbox"/> Telescoped, <input type="checkbox"/> Natural Development, <input type="checkbox"/> Open Hole, <input type="checkbox"/> Other (Describe) _____	
WELL GROUTED TO A DEPTH OF _____ FEET Type Grout (circle one): <input checked="" type="radio"/> Cement, <input type="radio"/> Bentonite, or Mix	

GEOLOGIC DATA (Office Use Only)			
Surface Elev.	Geologic Unit	Unit Thickness	Depth to Top
Subs. SWL	Date	Analysis	Aquifer Test

SCREEN DATA		
Diameter - Inches <i>2 in</i>	Length - Feet <i>8</i>	Slot Size - Inches <i>008</i>
Screen Type <i>P.V.C.</i>	Depth to Bottom - Feet <i>22 - 30</i>	

Driller's Remarks
Top of Lap Pipe or Reduction in Casing

DESCRIPTION OF FORMATIONS ENCOUNTERED	FROM	TO
<i>Top Soil</i>	<i>0</i>	<i>2</i>
<i>Clay</i>	<i>2</i>	<i>12</i>
<i>Red Gravel</i>	<i>12</i>	<i>30</i>


 JUN 18 1996
 Dept. of Environmental Quality
 Office of Land & Water Resources
 IF MORE SPACE IS NEEDED, USE BACK

