

MARION  
R 12  
1-70

MISSISSIPPI  
BOARD OF WATER COMMISSIONERS  
416 North State Street  
Jackson, Mississippi 39201

CODED

WATER WELL DRILLERS LOG

Jan. 1970 E. B. Sheward Marion  
date well completed firm name county well located

LANDOWNER:	description of formations encountered	from	to
Annie Anthony Rt. 5 - Columbia, Miss. (mailing address)	BRAY SANDY CLAY FINE SAND PEA GRAVEL & COARSE SAND	0 30 30 90	30 90 90 104
WELL LOCATION: sec. 9 T-1 N S R-17 E W 15 miles SSW of Columbia (distance) (direction) (nearest town)			
WELL PURPOSE: (home, irrigation, municipal, industrial)			
WELL COMPLETION DATA: (1) diameter (inches) 2" (2) total depth (feet) 104' (3) static water level (feet) 45' below top of ground (4) casing Plastic, 104' (material) (depth) 2" if telescope see back. (size) (5) screen 3' (length) (depth to top) 2 1/2" S.S. (size) (material) (6) pump 3/4 9 (HP) (yield gpm) (type power) (7) electric log (yes or no) (organization running log) (8) how well bottom plugged BN			

CODED


FEB 5 1970

MISS. RD. D  
WATER COM.

DRILLERS REMARKS:

If well telescopes please sketch and show depths.

GROUND LEVEL

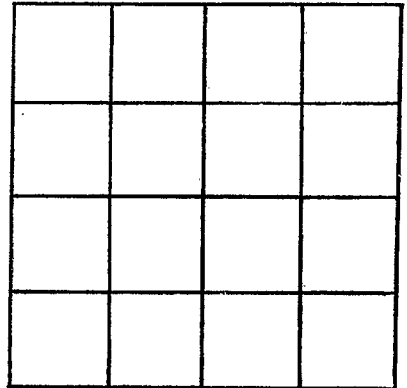

SECTION \_\_\_\_\_

Please indicate well location X.

ADDITIONAL INFORMATION

If more than one screen, show locations of each on sketch.