

MARION
R 13
3-72

MISSISSIPPI
 BOARD OF WATER COMMISSIONERS
 416 North State Street
 Jackson, Mississippi 39201

CODED

WATER WELL DRILLERS LOG

March 1972 E. B. Sheppard Marion
 date well completed firm name county well located

LANDOWNER:
Roy Brown
Rt. 5 - Columbia
 (mailing address)

description of formations encountered
SAND & GRAVEL @ 40'
 from to

WELL LOCATION:
 sec 29 T 1 N 17 E
15 miles SSW of Columbia
 (distance) (direction) (nearest town)

WELL PURPOSE:
 (home, irrigation, municipal, industrial)
home

WELL COMPLETION DATA:

(1) diameter (inches) 2"

(2) total depth (feet) 40

(3) static water level (feet) 15 below above top of ground.

(4) casing pl. 35'
 (material) (depth)

2" if telescope see back.
 (size)

(5) screen 5'
 (length) (depth to top)

2" pl.
 (size) (material)

(6) pump 1/2 9
 (HP) (yield gpm)

E
 (type power)

(7) electric log (yes or no)

(organization running log)

(8) how well bottom plugged Brw


CODED

JUN 26 1972

DRILLERS REMARKS:

If well telescopes please
sketch and show depths.

GROUND LEVEL

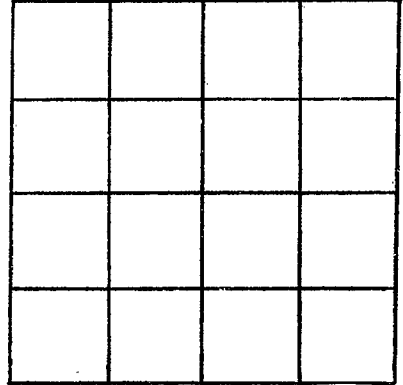

SECTION _____

Please indicate well location X.

ADDITIONAL INFORMATION

If more than one screen,
show locations of each on sketch.