

MARION
R17
2-71

MISSISSIPPI
BOARD OF WATER COMMISSIONERS
416 North State Street
Jackson, Mississippi 39201

CODED

WATER WELL DRILLERS LOG

FEB 1971 E.B. SHERARD MARION
date well completed firm name county well located

LANDOWNER:
GEORGE JEFFERSON

description of formations encountered from to
SAND + GRAVEL 0 44

Rt. 5 - COLUMBIA
(mailing address)

WELL LOCATION:
sec 29 T 1 N R17 E
1 1/2 miles SE of COLUMBIA
(distance) (direction) (nearest town)

WELL PURPOSE:
(home, irrigation, municipal, industrial)

WELL COMPLETION DATA:

- (1) diameter (inches) 2"
- (2) total depth (feet) 44
- (3) static water level (feet) 16 below top of ground.
- (4) casing PL (material), (depth),
2" if telescope see back.
(size)
- (5) screen 5' (length), (depth to top)
2" (size), PL (material)
- (6) pump 1/2 (HP), 10 (yield gpm)
E (type power)
- (7) electric log (yes or no)
(organization running log)
- (8) how well bottom plugged BWV

CODED


MAY 23 1971
MAY 27 1971

MISS. DE. OF
WATER COM.

DRILLERS REMARKS:

If well telescopes please sketch and show depths.

GROUND LEVEL

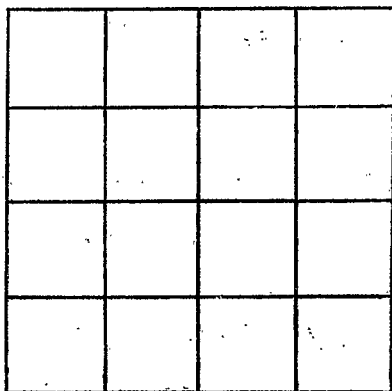

SECTION _____

Please indicate well location X.

ADDITIONAL INFORMATION

If more than one screen,
show locations of each on sketch.