

MARION
R 19
5-17-72

MISSISSIPPI
BOARD OF WATER COMMISSIONERS
416 North State Street
Jackson, Mississippi 39201

WATER WELL DRILLERS LOG

5-17-72 CABANIS MARION
date well completed firm name county well located

LANDOWNER:
A+B DAIRY
RT. 5
(mailing address)

WELL LOCATION:
sec. 11 T. 1 N. R. 17 E
7 miles SW BAYTERTOWN
(distance) (direction) (nearest town)

description of formations encountered	from	to
CLAY - YELLOW	0	16
SAND - WHITE	16	22
SAND - MED. WHITE W/STREAKS CLAY		
CLAY	22	69
SAND - MED. TO COARSE WHITE	69	100

WELL PURPOSE: DAIRY
(home, irrigation, municipal, industrial)

WELL COMPLETION DATA:

(1) diameter (inches) 4

(2) total depth (feet) 100

(3) static water level (feet) 30 below top of ground.

(4) casing PVC, 94 (material), (depth)
4 (size) if telescope see back.

(5) screen 6 (length), 94 (depth to top)
4 (size), PVC (material)

(6) pump 2 (HP), 35 (yield gpm)
ELECT (type power)

(7) electric log NO (yes or no)

CODED

(organization running log)

OCT - 6 1972


(8) how well bottom plugged
BACKWASH VALVE

DRILLERS REMARKS:

SEAL OF THE
MISSISSIPPI
BOARD OF WATER COMMISSIONERS

If well telescopes please sketch and show depths.

GROUND LEVEL

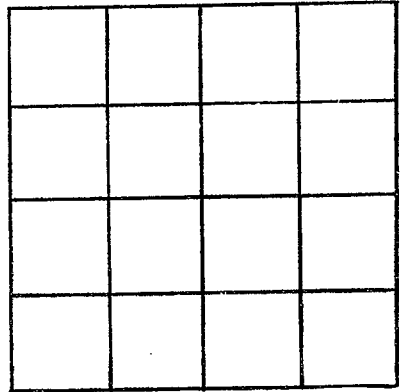

SECTION _____

Please indicate well location X.

ADDITIONAL INFORMATION

If more than one screen, show locations of each on sketch.