

MARION
R 20
12-3-72

MISSISSIPPI
BOARD OF WATER COMMISSIONERS
416 North State Street
Jackson, Mississippi 39201

WATER WELL DRILLERS LOG

CODED

Dec 3
date well completed

1972
firm name

Marion
county well located

LANDOWNER: Lloyd Smith
DH 4
Lumberton Miss
(mailing address)

description of formations encountered	from	to
Top Soil	0	6"
Clay	6"	38
Sand & Gravel	38	67

WELL LOCATION:

sec. 19 T 1 N R 17 E
-5- W
12 miles SE of Collierville
(distance) (direction) (nearest town)

CODED

WELL PURPOSE: Home
(home, irrigation, municipal, industrial)

WELL COMPLETION DATA:

- (1) diameter (inches) 2"
- (2) total depth (feet) 67'
- (3) static water level (feet) 47' below top of ground
- (4) casing Plastic 64'
(material) (depth)
2" if telescope see back.
(size)
- (5) screen 3' 17'
(length) (depth to top)
2" 2.5'
(size) (material)
- (6) pump 1 HP 6
(HP) (yield gpm)
Elec
(type power)
- (7) electric log _____
(yes or no)

(organization running log)


(8) how well bottom plugged
Foot Valve

DRILLERS REMARKS:

DEC 07 1972

If well telescopes please sketch and show depths.

GROUND LEVEL

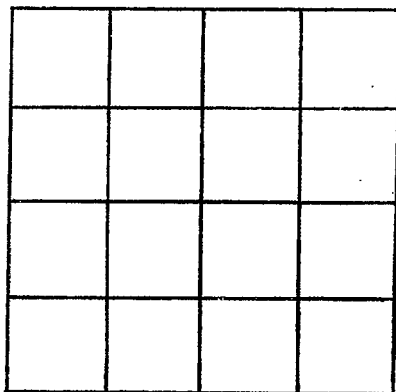

SECTION _____

Please indicate well location X.

ADDITIONAL INFORMATION

If more than one screen,
show locations of each on sketch.