

MARION
K21
3-1-74

MISSISSIPPI
BOARD OF WATER COMMISSIONERS
416 North State Street
Jackson, Mississippi 39201

CODED

WATER WELL DRILLERS LOG


3-1 1974 GRINER - GINN Marion county well located
date well completed firm name

LANDOWNER:	description of formations encountered	from	to
Mr. Bill Hamlin	Top Soil	0	3
1424 Whitney Bank Building	Clay	3	41
New Orleans, La. (mailing address)	Hard & Heavy	41	52
	Chalk	52	74
	Sand	74	135
<p>WELL LOCATION:</p> <p>sec 28 T 1 N R 17 E S S E</p> <p>18 miles S of Columbia (distance) (direction) (nearest town)</p> <p>WELL PURPOSE: Home (home, irrigation, municipal, industrial)</p> <p>WELL COMPLETION DATA:</p> <p>(1) diameter (inches) 4"</p> <p>(2) total depth (feet) 135</p> <p>(3) static water level (feet) 90 below above top of ground.</p> <p>(4) casing plastic, 125, (material) (depth) 4" If telescope see back. (size)</p> <p>(5) screen 10', 125 (length) (depth to top) 4", plastic (size) (material)</p> <p>(6) pump 3/4 10 (HP) (yield gpm) elec. (type power)</p> <p>(7) electric log NO (yes or no) NO (organization running log)</p> <p>(8) how well bottom plugged B.W. Valve</p>			
<p>DRILLERS REMARKS:</p>			
<p>MAY 23 1974</p> <p>MISS. BD. OF WATER COMMISSIONERS</p>			

CODED

If well telescopes please sketch and show depths.

GROUND LEVEL

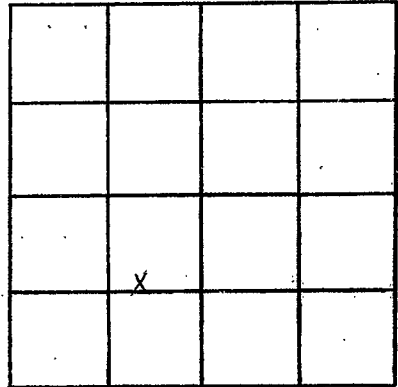

SECTION 28

Please indicate well location X.

ADDITIONAL INFORMATION

If more than one screen, show locations of each on sketch.