

MARION

LAMAR
R 22
10/78

MISSISSIPPI
BOARD OF WATER COMMISSIONERS
416 North State Street
Jackson, Mississippi 39201

CODED

WATER WELL DRILLERS LOG

MARION

Griner Drilling

Lamar

date well completed

firm name

county well located

LANDOWNER:
Gulf Oil Company
P.O. Box 1635
Houston, Texas
(mailing address)

description of formations encountered

from

to

Topsoil

0 21'

Clay

21 42

gravel

42 231

Clay-sand

231 294

gravel-sand

294 315

sand + gravel

315 336

WELL LOCATION:

sec. 12 T 10 N R 17 E
Baxterville, MS
(distance) (direction) (nearest town)

WELL PURPOSE: oil field supply
(home, irrigation, municipal, industrial)

WELL COMPLETION DATA:

- (1) diameter (inches) 3"
- (2) total depth (feet) 336'
- (3) static water level (feet) 60' ^{below} _{above} top of ground.
- (4) casing steel 315' (material) (depth)
3" (size) if telescope see back.
- (5) screen 42' 271' (length) (depth to top)
perforated (material)
- (6) pump - 75 (HP) (yield gpm)
AC (type power)
- (7) electric log - (yes or no)
(organization running log)
- (8) how well bottom plugged orange peel


RECEIVED
NOV - 1 1978

MISS. BD. OF WATER COMMISSIONERS

DRILLERS REMARKS:

If well telescopes please
sketch and show depths.

GROUND LEVEL

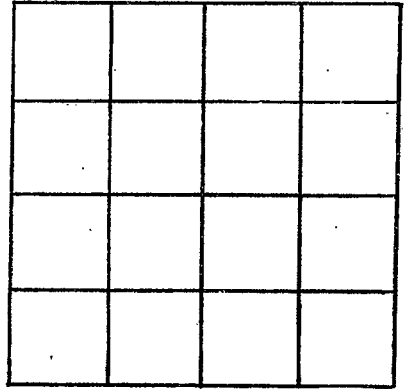

SECTION _____

Please indicate well location X.

ADDITIONAL INFORMATION

If more than one screen,
show locations of each on sketch.