

MARION

LAMAR

R23

8-31-79

MISSISSIPPI  
BOARD OF WATER COMMISSIONERS  
416 North State Street  
Jackson, Mississippi 39201

CODED

WATER WELL DRILLERS LOG

MARION

8-31 79 Griner Drilling

Lamar

date well completed

firm name

county well located

LANDOWNER:

Gulf Oil Corporation  
P.O. Box 471  
Columbia, MS 39429  
(mailing address)

description of formations encountered

from to

Top Soil	0	21
streaked	21	42
Clay	42	84
streaked	84	126
Clay	126	168
sand	168	252
pea gravel	252	378

WELL LOCATION: 317' S ↓ 400' E of  
sec. 12 T 1 N R 17 E NW 1/4  
Baylerville, Field  
(distance) (direction) (nearest town)

WELL PURPOSE: oil field supply  
(home, irrigation, municipal, industrial)

WELL COMPLETION DATA:

- (1) diameter (inches) 3"
- (2) total depth (feet) 378'
- (3) static water level (feet) 75' <sup>below</sup> <sub>above</sub> top of ground.
- (4) casing steel, 378'  
(material) (depth)  
3"  
(size) If telescope see back.
- (5) screen 42', 336'  
(length) (depth to top)  
3", perforated  
(size) (material)
- (6) pump —, 75  
(HP) (yield gpm)  
AC  
(type power)
- (7) electric log —  
(yes or no)

CODED

(organization running log)

(8) how well bottom plugged orange  
peel

DRILLERS REMARKS:


DEPT. OF NATURAL RESOURCES  
BUREAU OF LAND & WATER RESOURCES

OCT 26 1979

RECEIVED

If well telescopes please sketch and show depths.

GROUND LEVEL

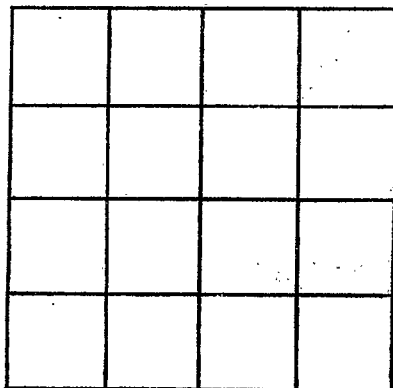

SECTION \_\_\_\_\_

Please indicate well location X.

ADDITIONAL INFORMATION

If more than one screen,  
show locations of each on sketch.