

MARION  
R-24

MISSISSIPPI  
BOARD OF WATER COMMISSIONERS  
416 North State Street  
Jackson, Mississippi 39201

11-30-79  
11-30-79  
date well completed

WATER WELL DRILLERS LOG

Tom Griffith  
firm name

Marion  
county well located

LANDOWNER:	description of formations encountered	from	to
Dr. Brown	Topsoil	0	1
	Chalk	1	80
(mailing address)	Sand	80	160
<b>WELL LOCATION:</b>			
sec. 33 T 1 N R 12 E 6 miles S of Springdale (distance) (direction) (nearest town)			
<b>WELL PURPOSE:</b> Home P. (home, irrigation, municipal, industrial)			
<b>WELL COMPLETION DATA:</b>			
(1) diameter (inches) 4"			
(2) total depth (feet) 160'			
(3) static water level (feet) 25' below top of ground.			
(4) casing Plastic, 146' (material) (depth)			
4" if telescope see back. (size)			
(5) screen 20', 146' (length) (depth to top)			
4", Stainless Steel (size) (material)			
(6) pump 5, 45' (HP) (yield gpm)			
Eject (type power)			
(7) electric log NO (yes or no)			
NONE (organization running log)			
(8) how well bottom plugged Occ.			
<b>DRILLERS REMARKS:</b>			


DEPT. OF NATURAL RESOURCES  
BUREAU OF LAND & WATER RESOURCES

JAN 7 1980

RECEIVED

If well telescopes please sketch and show depths.

GROUND LEVEL

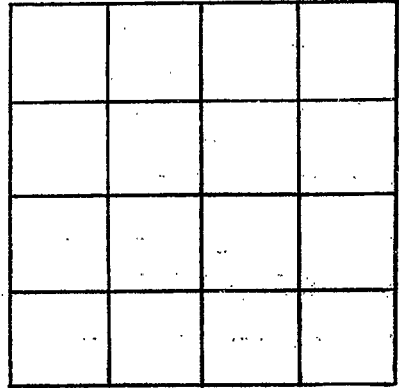

SECTION \_\_\_\_\_

Please indicate well location X.

ADDITIONAL INFORMATION

A series of horizontal lines for recording additional information, starting below the 'ADDITIONAL INFORMATION' header and extending to the bottom of the page.

If more than one screen, show locations of each on sketch.