

MARION

R-25
6-19-80

MISSISSIPPI
 BOARD OF WATER COMMISSIONERS
 416 North State Street
 Jackson, Mississippi 39201

CODED

WATER WELL DRILLERS LOG

date well completed 6-19-80 firm name Shiner Drilling Marion county well located

LANDOWNER:
Tenace Oil Co.
P.O. Box 7
Harvey, La.
 (mailing address)

description of formations encountered	from	to
<u>fill, sand</u>	<u>0</u>	<u>21</u>
<u>clay</u>	<u>21</u>	<u>42</u>
<u>sand + gravel</u>	<u>42</u>	<u>189</u>
<u>rock + clay</u>	<u>189</u>	<u>200</u>

WELL LOCATION: 1495'S & 920'W
2 1/2 miles W of Barterville Field
 (distance) (direction) (nearest town)

WELL PURPOSE: oil field supply
 (home, irrigation, municipal, industrial)

WELL COMPLETION DATA:

- (1) diameter (inches) 4"
- (2) total depth (feet) 200'
- (3) static water level (feet) 25' ^{below} above top of ground.
- (4) casing steel, 189'
 (material) (depth)
4" if telescope see back.
 (size)
- (5) screen 42', 147'
 (length) (depth to top)
4", perforated
 (size) (material)
- (6) pump 70
 (HP) (yield gpm)
AC
 (type power)
- (7) electric log
 (yes or no)

CODED

(organization running log)

(8) how well bottom plugged Change
peel


DRILLERS REMARKS:

DEPT. OF NATURAL RESOURCES
 BUREAU OF LAND & WATER RESOURCES

JUL - 2 1980
 RECEIVED

If well telescopes please
sketch and show depths.

GROUND LEVEL

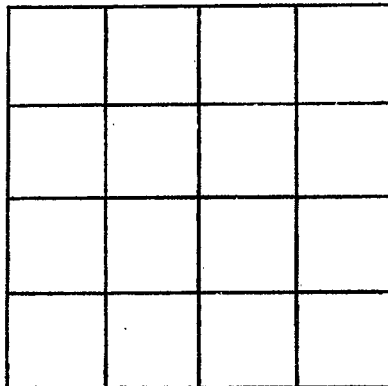

SECTION _____

Please indicate well location X.

ADDITIONAL INFORMATION

If more than one screen,
show locations of each on sketch.