


R26?

MISSISSIPPI BOARD OF WATER COMMISSIONERS
416 North State Street
Jackson, Mississippi 39201

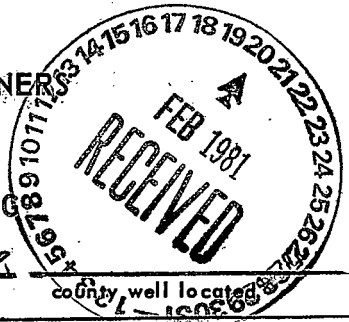

WATER WELL DRILLERS LOG

Winer City Seal Inc

date well completed 19

firm name

county, well located

LANDOWNER:

description of formations encountered

from

to

(mailing address)

WELL LOCATION:

sec. T N S R E W

miles _____ of _____ (nearest town)

WELL PURPOSE: *oil field supply*
(home, irrigation, municipal, industrial)

WELL COMPLETION DATA:

(1) diameter (inches) 4"

(2) total depth (feet) 483'

(3) static water level (feet) flow below/above top of ground.

(4) casing steel, 483'
(material) (depth)

40"
(size) If telescope see back.

(5) screen 42', 441'
(length) (depth to top)

4", perforated
(size) (material)

(6) pump —, 75
(HP) (yield gpm)

ac
(type power)

(7) electric log —
(yes or no)

(organization running log)

(8) how well bottom plugged range

DRILLERS REMARKS: peel

description of formations encountered	from	to
clay + sand	0	21
sand + gravel	21	126
clay, sand, gravel	126	147
clay	147	462
sand	462	483
clay + sand	483	504


DEPT. OF NATURAL RESOURCES
BUREAU OF LAND & WATER RESOURCES

FEB 20 1981

RECEIVED

If well telescopes please sketch and show depths.

GROUND LEVEL

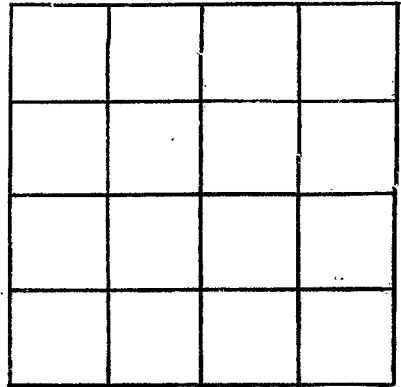

SECTION _____

Please indicate well location X.

ADDITIONAL INFORMATION

If more than one screen, show locations of each on sketch.