

MISSISSIPPI DEPARTMENT OF NATURAL RESOURCES

Bureau of Land and Water Resources

Southport Mall

P.O. Box 10631

CODED

Jackson, Mississippi 39209

WATER WELL DRILLERS LOG

R.30
MARION CO.
12-31-83

12-31-83
date well completed

Griner Drilling
Service, Inc.
firm name

Marion
county well located

LANDOWNER:	description of formations encountered	from	to
EXXON COMPANY U.S.A. P.O. Box 16050 New Orleans, La 70160 (mailing address)	fill	0	21
WELL LOCATION: 470W x 100'W sec. L T L N R 17 E SE/40R No. 7 DAVIS Baxterville Field Rt. 1 (distance) miles (direction) (nearest town)	sand, gravel	21	315
WELL PURPOSE: oil field supply (home, irrigation, municipal, industrial)	SE, SE, SB		
WELL COMPLETION DATA:			
(1) diameter (inches) 4"			
(2) total depth (feet) 315'			
(3) static water level (feet) 75' ^{below} _{above} top of ground.			
(4) casing steel, 315' (material), (depth) 4" (size) if telescope see back.			
(5) screen 42' (length), 273' (depth to top) 4" (size), perforated (material)			
(6) pump - (HP), 70-75 (yield gpm) AC (type power)			
(7) electric log (yes or no) (organization running log)			
(8) how well bottom plugged orange peel			
DRILLERS REMARKS:			

CODED


DEPT. OF NATURAL RESOURCES
BUREAU OF LAND & WATER RESOURCES

JAN 23 1984

RECEIVED

If well telescopes please
sketch and show depths.

GROUND LEVEL

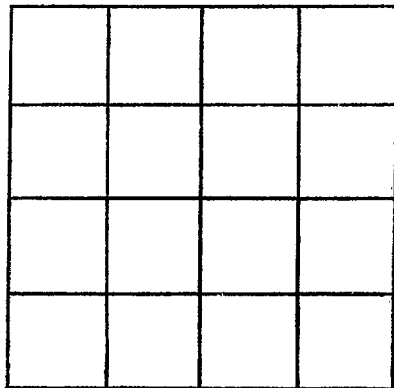

SECTION _____

Please indicate well location X.

ADDITIONAL INFORMATION

If more than one screen,
show locations of each on sketch.