

MISSISSIPPI DEPARTMENT OF NATURAL RESOURCES

Bureau of Land and Water Resources

Southport Mall

CODED

P.O. Box 10631

Jackson, Mississippi 39209

WATER WELL DRILLERS LOG

Griner Drilling Service, Inc.

Marion

R31  
MARION  
4-2-84

4-2-84 date well completed

Griner Drilling Service, Inc. firm name

Marion county well located

LANDOWNER:	description of formations encountered	from	to
Marshall R. Young 750 West 5th Street Fort Worth, Texas 76102 (mailing address)	Sand	0	35
	clay	CODED 35	89
WELL LOCATION: 200'S + 200' W sec. 13 T. 10 N. R. 17 NE/40 No. 19 Baxterville Field R.L. (distance) miles (direction) of (nearest town)	streaked	89	180
	sand, gravel	180	240
WELL PURPOSE: Oil Field supply (home, irrigation, municipal, industrial)	clay, streaks	240	255
WELL COMPLETION DATA:			
(1) diameter (inches) 4"			
(2) total depth (feet) 252'			
(3) static water level (feet) 60' below top of ground.			
(4) casing steel, 231' (material), (depth)			
4" (size) if telescope see back.			
(5) screen 42' length, 189' depth to top			
4" perforated (size), (material)			
(6) pump — (HP), 75-80 (yield gpm)			
AC (type power)			
(7) electric log — (yes or no)			
(organization running log)			
(8) how well bottom plugged ORANGE PEEL			
DRILLERS REMARKS:			


DEPT. OF NATURAL RESOURCES  
BUREAU OF LAND & WATER RESOURCES

APR 12 1984

RECEIVED

If well telescopes please sketch and show depths.

GROUND LEVEL

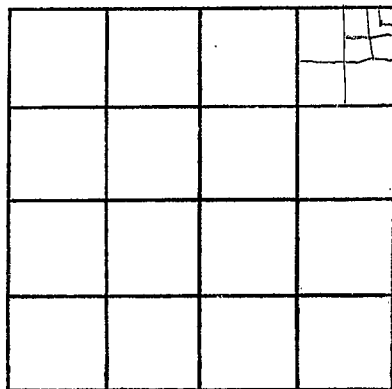

SECTION \_\_\_\_\_

Please indicate well location X.

ADDITIONAL INFORMATION

If more than one screen,  
show locations of each on sketch.