

MISSISSIPPI DEPARTMENT OF NATURAL RESOURCES

Bureau of Land and Water Resources

Southport Mall

P.O. Box 10631

Jackson, Mississippi 39209

CODED

WATER WELL DRILLERS LOG

Griner Drilling Service, INC.

Marion

R32
MARION CO.
4-3-84

4-3-84 date well completed

Griner Drilling Service, INC. firm name

Marion county well located

LANDOWNER:

Marion Drilling
P.O. Box 3027
Daphne, Alabama
(mailing address)

description of formations encountered

from

to

clay, sand	0	80
sand, pea gravel	80	252
sand, pea gravel, clay	252	273

WELL LOCATION:

150 S + 150 W of
sec. 12, 10 N R. 17 E NE 1/4 of
No. 13 skew Baxterville Field
As (distance) miles (direction) of (nearest town)

WELL PURPOSE: oil field supply
(home, irrigation, municipal, industrial)

WELL COMPLETION DATA:

- (1) diameter (inches) 4"
- (2) total depth (feet) 273'
- (3) static water level (feet) 70' ^{below} ~~above~~ top of ground.
- (4) casing steel, 252'
(material) (depth)
4'
(size) if telescope see back.
- (5) screen 42', 210'
(length) (depth to top)
4", perforated
(size) (material)
- (6) pump —, 75-80
(HP) (yield gpm)
AC
(type power)
- (7) electric log —
(yes or no)

(organization running log)

- (8) how well bottom plugged orange peel

DRILLERS REMARKS:


DEPT. OF NATURAL RESOURCES
BUREAU OF LAND & WATER RESOURCES

APR 12 1984

RECEIVED

If well telescopes please sketch and show depths.

GROUND LEVEL

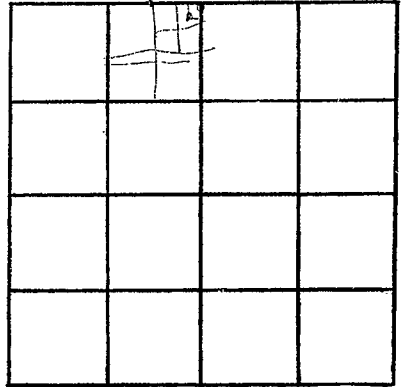

SECTION _____

Please indicate well location X.

ADDITIONAL INFORMATION

If more than one screen,
show locations of each on sketch.