

MISSISSIPPI DEPARTMENT OF ENVIRONMENTAL QUALITY

Office of Land and Water Resources

P. O. Box 10631
Jackson, MS 39289-0631

WATER WELL DRILLERS LOG

COUNTY WELL LOCATED
Marion

WELL NUMBER R-42 CODED

DATE WELL COMPLETED
7/20/09

PERMIT NUMBER

NAME OF DRILLING FIRM
Jordan Well Ser.

NAME & MAILING ADDRESS OF LANDOWNER
Daniel Braun
60 St. Paul Rd
Sandy Hook, Ms

Latitude:

Longitude:

WELL LOCATION. SEC 4 TOWNSHIP 1 S RANGE 17 E

DISTANCE 7 Miles DIRECTION S of NEAREST TOWN Foxworth

OTHER LANDMARK

WELL PURPOSE: Home Irrigation, Municipal, Industrial, Fish Pond, etc.

PUMP DATA

PUMP TYPE (Circle One):
Submersible Turbine, Jet, Flowing Well,
Other (Describe)

POWER TYPE (Circle One):
Electric Tractor, Diesel, Gasoline, Butane,
Other (Describe) H/P 1/2

DESCRIPTION OF FORMATIONS ENCOUNTERED	FROM	TO
<u>Top Soil</u>	<u>0</u>	<u>1</u>
<u>Sandy Clay</u>	<u>1</u>	<u>12</u>
<u>Sand & Gravel</u>	<u>12</u>	<u>55</u>

WELL DATA

Well Depth 55 Casing Diameter (In.) 4 Casing Length (Ft.) 45

Type of Casing PVC Hole Depth 55 Depth to Static Water Level 12

TYPE OF COMPLETION: (Circle One or More):
Gravel Packed, Underreamed, Telescoped,
Natural Development, Open Hole, Other
(Describe)

WELL GROUTED TO A DEPTH OF 10 FEET
Type Grout (circle one): Cement, Bentonite, or Mix Mix

SCREEN DATA

Diameter - Inches 4 Length - Feet 10 Slot Size - Inches .010

Screen Type PVC Depth to Bottom - Feet 45

Top of Lap Pipe or Reduction in Casing

FEET IF TELESCOPED OR MORE THAN ONE SCREEN: USE BACK PAGE

RECEIVED

AUG 04 2009

BY: OLW

I certify that the well was drilled, constructed and completed in accordance with all applicable Requirements of the Mississippi Department of Environmental Quality and/or the Mississippi Department of Health regulations and state laws.


[Signature] 0-508
Signature of Licensed Driller and License No.

7/20/09
Date

Additional Information Required On Back

If well telescopes please sketch and show depths.

GROUND LEVEL

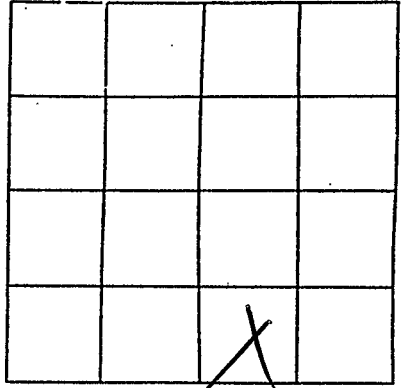

SECTION 4

Please indicate well location X.

Pump Capacity (GPM) <u>10</u>	No. of Stages <u>8</u>	Setting Depth <u>50</u> FT.
----------------------------------	---------------------------	--------------------------------

PUMP TEST

Well yielded _____ GPM with
a drawdown of _____ ft.
after _____ hours of pumping

LOG DATA

TYPE OF LOG RUN (Circle One): _____ No Log Run,
Electric, Gamma Ray, Density, Sonic, Neutron,
Other (Describe) _____

Name of Organization Running Log _____

GEOLOGIC DATA (Office Use Only)

Surface Elev.	Geologic Unit	Unit Thickness	Depth to Top
Subs. SWL	Date	Analysis	Aquifer Test

Driller's Remarks

If more than one screen,
show location of each on sketch.