*				
marion		ell Report	For Office Use Only:	
County: Lamar	Part 1			
· _		t of Environmental Quality	Aquifer:	
Permit #:Routhono	Office of Land and Water Resources P.O. Box 10631		Well #:61	
Driller: Glary Kayporn	Jackson, MS 39289-0631		L. S. Elevation:	
Date drilling completed: 2/9/07		961-5210	E-log #:	
	(601)354	4-6938 (fax)	E-log #	
State Law requires that this rep 30 days of completion of drilling	oort be prepared by the g of the well.			
Well Owner Inform	ation	Wel	l Location	
Owner Name DJD Drill		Latitude: <u>31 ° 0'3 ' 1 2</u>	_" Longitude: <u>8^C] • 40 • 04</u> ."	
Mailing Address: P. D ' BC	$\frac{1634}{1634}$ Method of Lat/Long (circle o			
	USGS quad, Hand-he			
Ferriday, L	A 71334	NW 1/4 NW 1/4 Sec 13	Twn IN Rng 17W	
City St Telephone No. <u>318) 757- 3</u>	Tate Zip Code	Distance Direction	of Bax-erville	
	Well	Data		
Purpose of Well (circle one) Home In Date well drilling started: 2920	dustrial Public Supply	Irrigation Fish Culture well drilling completed:		
			•	
If flowing, method of flow regulation: V Static Water Level:feet	alve Other (land surface Date measured	2907	
Static Water Level: feet	above or velow (circle one)			
Method of Measurement (circle one)	steel tape electric tape	e air line other:	1 .	
Hole depth: 200 Well of	iepth: 200	Well grouted to a depth of	feet	
Type of grout (circle one): Cement	Bentonite Mix		•	
Casing length: 180 feet Ca	sing diameter:	inches Type of casing:	PVC	
Sereen rengin	creen diameter:		PVC 11 2007	
Screen slot size: <u>•020</u> inches		feet to2		
Type of completion (circle all applicable	e): Gravel packed Unde	erreamed Telescoped Ope	en hole inatural Development	
Top of lap pipe or reduction in casing:				
Logs run (circle all applicable): No log	run Electric Gamma Ra	y Density Sonic Neutron	Other:	
Name of organization running log(s): I certify that the well was drilled, con	two stad and completed in	accordance with all annlicah	le requirements of the Mississippi	
I certify that the well was drilled, con	structed, and completed in	accordance with an applicab	ns and state laws.	
Department of Environmental Quality	y and/or the Mississippi D	epartment of riealth regulatio	In and state land.	
RAYBORN DRILLING, INC.	0-60		<u> </u>	
Print Name of Water Well Contractor a	nd License No.	Signature	of Water Well Contractor	


If well telescopes please sketch below and show depths.

Ground Level

<u>,</u>_+

el	Description of Formations Encountered	From	To
	chalk	0	15
	Sand	15 40	40
	Coarse sand	(00	140
	Ehalk Fine Sand	140	170
	med Sand	170	200
			ļ
			+
			1
			T
			<u> </u>
			+
			1

If more than one screen, show location of each on sketch

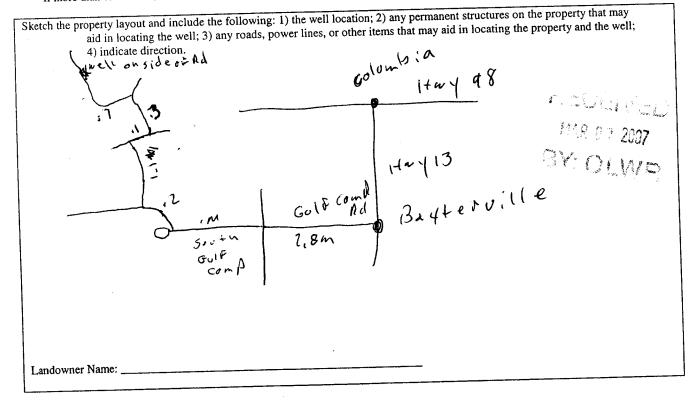

Signature of Water Well Contractor

R-61

County: Lamar Permit #:		STATE WELL REPORT Part 2 Pump Installer's Completion Report Mississippi Department of Environmental Quality Office of Land and Water Resources		For Office Use Only: Aquifer:	
Driller: Gary Ro Date completed: 20		Jackson, I (601	Box 10631 MS 39289-0631)961-5210 54-6938 (fax)	Well #: <u>R-61</u> Elevation:	
installation of pur	np.		ail and filed with the Departme		
Well Owner Information		Well Location			
Owner Name: DtD Drilling Inc		Latitude:Longitude:			
Mailing Address: P. D. Box 1634			Method of Lat/Long (circle one): Conventional Survey,		
		-	USGS quad, Hand-held GPS, Survey-grade GPS		
Ferriday LA 71334 City State Zip Code		<u>14 Sec_13_Twn_IN_Rng_17W</u>			
			Distance Direction	_	
Telephone No. (318)	<u>, 75'1- :</u>	3274		of Baxterville	
	Pump Type			ower Type Circle one	
Circle one					
Air Lift	Jet	Submersible	Diesel Engine Gasol	ine Engine Natural Gas	
Bucket	Piston	Turbine	Electric Motor Hand		
Centrifugal	Rotary	Flowing Well		r (specify):	
Other (specify):			Horse Power Rating of Moto	or: <u>5</u>	
Date Pump Installed: 2907		Setting Depth:	feet		
Rated Pump Capacity:	100	Gallons Per Minute	Number of Stages:	y	
				Teasuring Water Level	
Pump Test Data			Circle one		
Date Well Tested: <u>2-9-07</u>		Air Line Electric M	easuring Line Steel Tape		
Static Water Level (A): <u>60</u> F	eet Below Land Surface	Other (specify):		
Pumping Water Level	(B):F	eet Below Land Surface			
Drawdown [(B) – (A)]:F	Feet Below Land Surface	- ,	shut in head:feet	
Test Pumping Rate: _	60	Gallons Per Minute	Well yielded	GPM with a drawdown of	
Duration of Pump Te	st (minimum 4 hou	nrs):hours	feet after	hours of pumping	