Rigl						
·, Kemp 2-4-364	State W	all Report				
County Marion	State Well Report Part 1		For Office Use Only:			
County: Mar 1011 M	Mississippi Department of Environmental Quality		Aquifer:			
Permit #:	Office of Land and Water Resources P.O. Box 10631		Well #:			
Driller: Gary Rayborn		S 39289-0631	L. S. Elevation:			
Date drilling completed: <u>11-25-08</u>		61-5210 -6938 (fax)	E-log #:			
State Law requires that this report	State Law requires that this report be prepared by the driller in detail and filed with the Department within					
30 days of completion of drilling of Well Owner Informatio	days of completion of drilling of the well.		Location			
Owner Name D + D Drill			" Longitude: <u>89 •41 •13</u> "			
Mailing Address:	Method of Lat/Long (circle o		ne): Conventional Survey,			
P.O. Box I	634	USGS quad; Hand-held	GPS, Survey-grade GPS			
Ferriday LA	A 71334 NW 4 NW 4 Sec 2		$\underline{}_{\text{Twn}} \underline{/ \gamma}_{\text{Rng}} \underline{/ \gamma u}$			
City / State Telephone No. (318) 157-327	City State Zip Code Distance Direction Selephone No. (318) 157-3274 Distance Direction Smiles W/Su		of <u>Baxteruille</u>			
	Well I	Data				
Burnass of Well (circle one) Home Indus	trial Public Supply	Irrigation Fish Culture	Other: Rig Supply			
Purpose of Well (circle one) Home Industrial Public Supply Irrigation Fish Culture Other: 11-35-08 Date well drilling started: 11-35-08 Date well drilling completed: 11-35-08						
If flowing, method of flow regulation: Valve	If flowing method of flow regulation: Valve Other (describe)					
Static Water Level:feet above of below (circle one) land surface Date measured:						
Method of Measurement (circle one) steel tape electric tape air line other:						
Hole depth: 2001 Well depth: 2001 Well grouted to a depth of 10 feet						
Type of grout (circle one): Cement	Bentonite Mix		\mathcal{O} , ic			
Casing length: 180 feet Casing	g diameter:4	inches Type of casing:	PVC			
Screen length: <u>20</u> feet Screen	Screen length: <u>20</u> feet Screen diameter: <u>4</u> inches Type of screen: <u>PVC</u>					
Screen slot size: <u>1020</u> inches	Setting depth: From	180_feet to	200 feet			
Type of completion (circle all applicable):	Gravel packed Under	rreamed Telescoped Ope	n hole Natural Development			
Other (describe):						
Top of lap pipe or reduction in casing:feet. If telescoped or more than one screen, describe on back of page						
Logs run (circle all applicable): No log run Electric Gamma Ray Density Sonic Neutron Other:						
Name of organization running log(s):						
Department of Environmental Quality and/or the Mississippi Department of Health regulations and state laws.						
	0-60	7				
RAYBORN DRILLING, INC.		Signature	of Water Well Contractor			
Print Name of Water Well Contractor and License No. Signature of Water Well Contractor						
RECEIVED						
			DEC 2 4 2008			


BY:	\cap	1	۱۸/	D
$\boldsymbol{\mathcal{D}}$	\mathbf{U}	L	V V	п

If well telescopes please sketch below and show depths.



Description of Formations Encountered	From To
Red Sandy Clay	0 60
White Chalk	60 140
Fire Sand	140 160
Medium Sand	160 200
	<u>_</u>

If more than one screen, show location of each on sketch

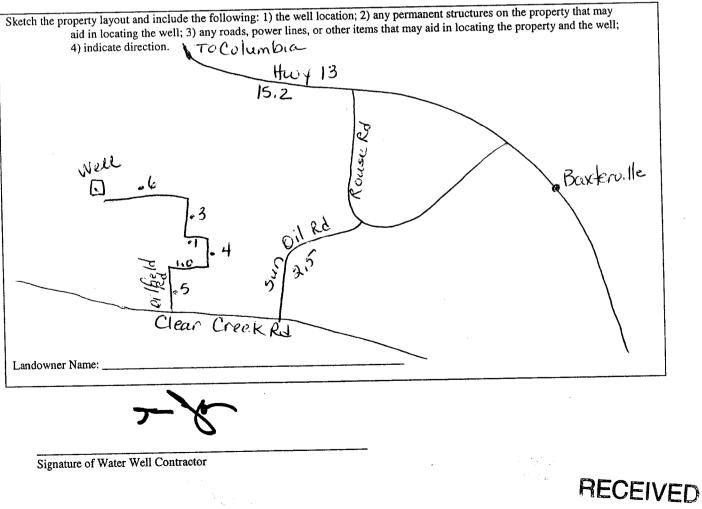

DEC 2 4 2008 BY: OLWR

9-78

	LL REPORT				
County: <u>Maruan</u> Permit #: Driller: <u>Jarug Rayborn</u> Date completed: <u>11-25-08</u> Pump Installer's Mississippi Department Office of Land ar P.O. B Jackson, M (601)5 (601)354	For Office Use Only: Completion Report of Environmental Quality advater Resources ox 10631 S 39289-0631 061-5210 4-6938 (fax)				
This report should be prepared by the pump installer in detail and filed with the Department within 30 days of the installation of pump.					
Well Owner Information Owner Name: Or O Orilling, Ind; Mailing Address: <u>G.O., Box</u> 1634 <u>Jerriday</u> LA 71334 City State Zip Code Telephone No. (<u>318)</u> 757 - 3274	Well Location Latitude: Method of Lat/Long (circle one): Conventional Survey, USGS quad, Hand-held GPS, Survey-grade GPS 14 4 Sec_2 Twn 1N Rng 1W Distance Direction Nearest Town				
Pump Type Circle one	Power Type Circle one				
Air LiftJetSubmersibleBucketPistonTurbine	Diesel EngineGasoline EngineNatural GasElectric MotorHandTractor PTO				
Centrifugal Rotary Flowing Well Other (specify):	Windmill Other (specify): Horse Power Rating of Motor:				
Pump Test Data Pump Test Data Date Well Tested: $11-35-08$ Static Water Level (A): 110 Feet Below Land Surface Pumping Water Level (A): 110 Feet Below Land Surface Drawdown [(B) – (A)]: Feet Below Land Surface Test Pumping Rate: 60 Gallons Per Minute Duration of Pump Test (minimum 4 hours):hours	Method of Measuring Water Level Circle one Air Line Electric Measuring Line Steel Tape Other (specify):				
I HEREBY CERTIFY that the above statements are true to the best $Gary Rayborn O-GO$ Print Name of Pump Installer and License No. (if applicable)					

DEC 2 4 2008 BY: OLWR