

Marion
R 2000,
9/75

MISSISSIPPI
BOARD OF WATER COMMISSIONERS
416 North State Street
Jackson, Mississippi 39201

WATER WELL DRILLERS LOG

Sept. 25 1975 E.B. Sherrard Marion
date well completed firm name county well located

LANDOWNER:
Mary Abram
Rt. 5 - Columbia, Ms.
(mailing address)

description of formations encountered	from	to
SAND & GRAVEL	0	35'

WELL LOCATION:
sec. 7 T. 1 N. R. 17 E. 134
13 miles SE of Columbia
(distance) (direction) (nearest town)

WELL PURPOSE:
(home) Irrigation, municipal, industrial


- WELL COMPLETION DATA:
- (1) diameter (inches) 2"
 - (2) total depth (feet) 35'
 - (3) static water level (feet) 18' ^{below} above top of ground.
 - (4) casing pl. 30'
(material) (depth)
2" if telescope see back.
(size)
 - (5) screen 5'
(length) (depth to top)
2" pl.
(size) (material)
 - (6) pump 1/3 7
(HP) (yield gpm)
E
(type power)
 - (7) electric log (yes or no)
(organization running log)
 - (8) how well bottom plugged BWV

DRILLERS REMARKS:

RECORDED
DEC - 5 1975
MISS. BD. OF WATER COMMISSIONERS

If well telescopes please sketch and show depths.

GROUND LEVEL

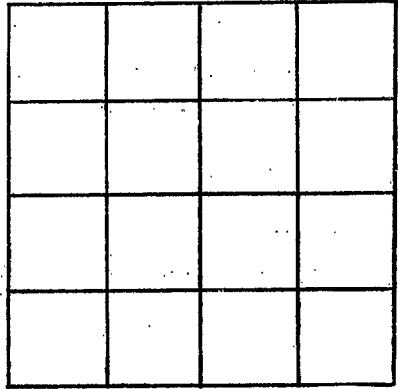

SECTION _____

Please indicate well location X.

ADDITIONAL INFORMATION

If more than one screen,
show locations of each on sketch.