

Marion
R 2003
Jan. 1976

MISSISSIPPI
BOARD OF WATER COMMISSIONERS
416 North State Street
Jackson, Mississippi 39201

WATER WELL DRILLERS LOG

JAN 1976 date well completed
136 R. SHERARD firm name
MARION county well located

LANDOWNER: RUTH ABRAM
Columbia, Miss.
(mailing address)

description of formations encountered
SAND & GRAVEL
STREAKS WITH
GRAY CLAY
PEA GRAVEL SAND

from 0 to 60
60 90

WELL LOCATION:
sec. 17 T. 1 N. R. 17 E.
S W
15 miles SE of Columbia
(distance) (direction) (nearest town)

WELL PURPOSE:
(home, irrigation, municipal, industrial)

- WELL COMPLETION DATA:
- (1) diameter (inches) 2"
 - (2) total depth (feet) 80'
 - (3) static water level (feet) 18' below above top of ground.
 - (4) casing pl. 25' (material) (depth)
2" (size) if telescope see back.
 - (5) screen 5' (length) (depth to top)
2" pl. (size) (material)
 - (6) pump 1/3 (HP) 10 (yield gpm)
e.l.c. (type power)
 - (7) electric log (yes of no) (no)
 - (8) how well bottom plugged BWV


DRILLERS REMARKS:

RECEIVED
OCT 18 1976

MISS. BD. OF WATER COMMISSIONERS

If well telescopes please
sketch and show depths.

GROUND LEVEL

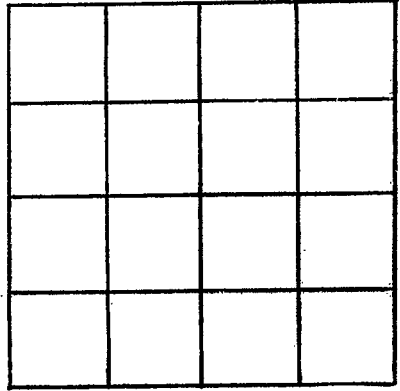

SECTION _____

Please indicate well location X.

ADDITIONAL INFORMATION

If more than one screen,
show locations of each on sketch.