

Marion
 R 2004
 12/20/77

MISSISSIPPI
 BOARD OF WATER COMMISSIONERS
 416 North State Street
 Jackson, Mississippi 39201

WATER WELL DRILLERS LOG

Dec 20 1977 date well completed
 Ginn Plumbing firm name
 Marion county well located


LANDOWNER:	description of formations encountered	from	to
Mr. Harvey Shotwell			
Rt. 5 - Box 168 Columbia	CLAY	1	11
(mailing address) Miss.	CHALK	11	32
	SAND	32	80
WELL LOCATION:			
sec. 9 T. 1 N. R. 17 E			
2 miles S.W. of Spring Catfish			
(distance) (direction) (nearest town)			
WELL PURPOSE: Home (home, irrigation, municipal, industrial)			
WELL COMPLETION DATA:			
(1) diameter (inches) 2"			
(2) total depth (feet) 80 ft.			
(3) static water level (feet) 55 below top of ground.			
(4) casing Plastic, 70 ft (material) (depth)			
2" (size) if telescope see back.			
(5) screen 10 ft, 70 ft (length) (depth to top)			
2" Plastic (size) (material)			
(6) pump 1/2 (HP) (yield gpm)			
Elec (type power)			
(7) electric log No (yes or no)			
(organization running log)			
(8) how well bottom plugged B.W. Valve			
DRILLERS REMARKS:			

RECEIVED
 MAR - 2 1978

MISS. BD. OF WATER COMMISSIONERS

If well telescopes please sketch and show depths.

GROUND LEVEL

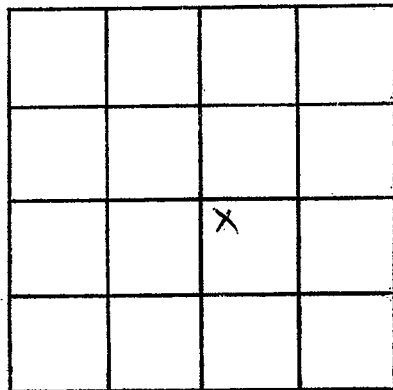

SECTION 9

Please indicate well location X.

ADDITIONAL INFORMATION

If more than one screen, show locations of each on sketch.