

Marion  
R 2005  
6-8-81

MISSISSIPPI  
BOARD OF WATER COMMISSIONERS  
416 North State Street  
Jackson, Mississippi 39201  
WATER WELL DRILLERS LOG

6-8 1981 Hollingsen Marion  
date well completed firm name county well located

LANDOWNER: Douglas Kessler  
RT 5  
Columbia, Ms.  
(mailing address)

description of formations encountered	from	to
Red clay gravel	0	60
CHALK	80	90
peat gravel	90	127

WELL LOCATION:  
sec. 20 T 1 N R 17 E  
6 miles SE of Spring Cotton  
(distance) (direction) (nearest town)

WELL PURPOSE:  
(home, irrigation, municipal, industrial)

WELL COMPLETION DATA:

(1) diameter (inches) 2"  
(2) total depth (feet) 127  
(3) static water level (feet) \_\_\_\_\_ below top of ground.  
(4) casing PVC, 122 (material) (depth)  
(size) If telescope see back.  
(5) screen 5, 122 (length) (depth to top)  
2, PVC (size) (material)  
(6) pump 1/8 (HP) (yield gpm)  
elec (type power)  
(7) electric log (yes or no)  
(organization running log)


(8) how well bottom plugged sand  
SHALIC

DRILLERS REMARKS: good well

DEPT. OF NATURAL RESOURCES  
BUREAU OF LAND & WATER RESOURCES


AUG 26 1981

RECEIVED

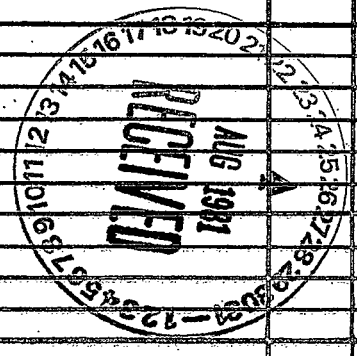

If well telescopes please sketch and show depths.

GROUND LEVEL

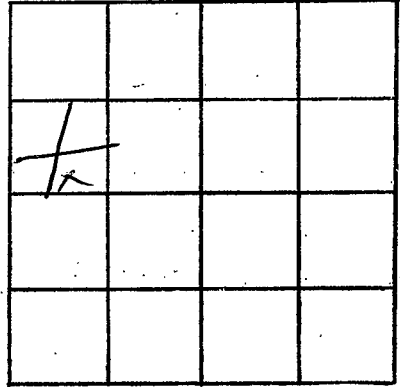

SECTION 20

Please indicate well location X.

ADDITIONAL INFORMATION

Multiple horizontal lines for additional information.

If more than one screen, show locations of each on sketch.