

Marion
R2006

MISSISSIPPI
BOARD OF WATER COMMISSIONERS
416 North State Street
Jackson, Mississippi 39201

WATER WELL DRILLERS LOG

11-18-81 19 Tom Griffiths Water Well MARION
date well completed firm name county well located

LANDOWNER:
ERNESTINE GARDN
RT. 5 Box 137D Columbia, Miss.
(mailing address)

description of formations encountered	from	to
<u>TOPSOIL</u>	<u>0</u>	<u>1</u>
<u>CHALK</u>	<u>1</u>	<u>18</u>
<u>GRAVEL</u>	<u>18</u>	<u>50</u>
<u>Black Dga GRAVEL & SAND</u>	<u>50</u>	<u>80</u>

WELL LOCATION:
sec. 8 T. 1 N R. 12 E
5 miles SE of Friend College
(distance) (direction) (nearest town)

WELL PURPOSE: HOME
(home, irrigation, municipal, industrial)

- WELL COMPLETION DATA:
- (1) diameter (inches) 2"
 - (2) total depth (feet) 80'
 - (3) static water level (feet) 20' below above top of ground.
 - (4) casing DVC 80'
(material) (depth)
2"
(size) If telescope see back.
 - (5) screen 20' 60'
(length) (depth to top)
2" DVC
(size) (material)
 - (6) pump 1/2 Elect.
(HP) (yield gpm)
(type power)
 - (7) electric log
(yes or no)

(organization running log)
 - (8) how well bottom plugged BULL.

DRILLERS REMARKS:


DEPT. OF NATURAL RESOURCES
BUREAU OF LAND & WATER RESOURCES

JUN - 9 1982

RECEIVED

If well telescopes please sketch and show depths.

GROUND LEVEL

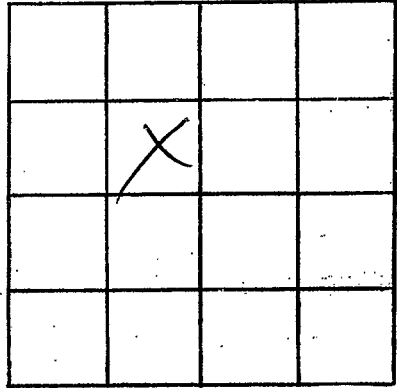

SECTION 8

Please indicate well location X.

ADDITIONAL INFORMATION

Lined area for additional information.

If more than one screen, show locations of each on sketch.