

MISSISSIPPI DEPARTMENT OF NATURAL RESOURCES

Bureau of Land and Water Resources

Southport Mall

P.O. Box 10631

Jackson, Mississippi 39209

WATER WELL DRILLERS LOG

Union
R 2009

May 25 1983 Remer Well Inc Union  
 date well completed firm name county well located

LANDOWNER: David Buckley  
St. Columbias  
 (mailing address)

description of formations encountered	from	to
<u>Clay</u>	<u>0</u>	<u>18</u>
<u>White sand</u>	<u>18</u>	<u>40</u>
<u>Chalk shell</u>	<u>130</u>	<u>160</u>
<u>Coarse sand</u>	<u>160</u>	<u>185</u>

WELL LOCATION:  
 sec. 19 T. 1 N R. 17 E  
13 miles S of Columbia  
 (distance) (direction) (nearest town)

WELL PURPOSE: Trailer  
 (home, irrigation, municipal, industrial)

WELL COMPLETION DATA:

(1) diameter (inches) 4"

(2) total depth (feet) 185

(3) static water level (feet) 30 below above top of ground.

(4) casing plastic bottom  
 (material) (depth)

  if telescope see back.  
 (size)

(5) screen 10 175  
 (length) (depth to top)

4" plastic  
 (size) (material)

(6) pump 3 hp 12  
4 (HP) (yield gpm)

electric  
 (type power)

(7) electric log no  
 (yes or no)

   
 (organization running log)

(8) how well bottom plugged  
back wash

DRILLERS REMARKS:  
none


DEPT. OF NATURAL RESOURCES  
 BUREAU OF LAND & WATER RESOURCES

SEP 28 1983

RECEIVED

If well telescopes please sketch and show depths.

GROUND LEVEL

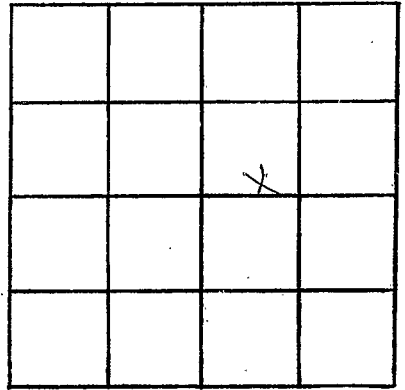

SECTION 19

Please indicate well location X.

ADDITIONAL INFORMATION

If more than one screen,  
show locations of each on sketch.