

Marion
R0010

MISSISSIPPI DEPARTMENT OF NATURAL RESOURCES
Bureau of Land and Water Resources
Southport Mall
P.O. Box 10631
Jackson, Mississippi 39209
WATER WELL DRILLERS LOG

4-5 1988 Hollinger Marion
date well completed firm name county well located


LANDOWNER: <u>James A Smith</u> <u>RT 5 Box 277</u> <u>Spring Cottage, MS</u> (mailing address)	description of formations encountered	from	to
WELL LOCATION: sec. <u>8</u> T. <u>10</u> N. R. <u>17</u> E. <u>20</u> miles <u>SE</u> of <u>Columbus</u> (distance) (direction) (nearest town)	<u>Red clay chalk</u> <u>sand, chalk</u> <u>pl. gravel</u>	<u>0</u> <u>60</u> <u>160</u>	<u>60</u> <u>160</u> <u>210</u>
WELL PURPOSE: (home, <u>irrigation</u> , municipal, industrial)			
WELL COMPLETION DATA:			
(1) diameter (inches) <u>4</u>			
(2) total depth (feet) <u>210</u>			
(3) static water level (feet) <u>60</u> (<u>below</u> above top of ground.)			
(4) casing <u>pvc</u> , <u>190</u> (material) (depth)			
_____ if telescope see back. (size)			
(5) screen <u>20</u> , <u>190</u> (length) (depth to top)			
(6) pump <u>4</u> , <u>pvc</u> (size) (material)			
(6) pump <u>5</u> , <u>100</u> (HP) (yield gpm)			
(7) electric log <u>elect</u> (type power)			
(7) electric log _____ (yes or no)			
_____ (organization running log)			
(8) how well bottom plugged, <u>sand</u> <u>stuck</u>			
DRILLERS REMARKS: <u>Very good well</u>			

RECEIVED
MAY 19 1988
NPR

Department of Natural Resources
Bureau of Land & Water Resources

If well telescopes please sketch and show depths.

GROUND LEVEL

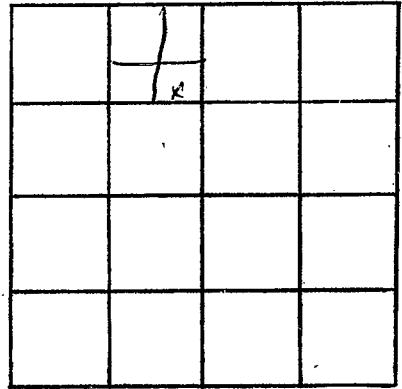

SECTION 8

Please indicate well location X.

ADDITIONAL INFORMATION

If more than one screen,
show locations of each on sketch.