

CODED

MISSISSIPPI
BOARD OF WATER COMMISSIONERS
416 North State Street
Jackson, Mississippi 39201

WATER WELL DRILLERS LOG

Marshall Co
A7
8-69

8-5-1969
date well completed

Bob Smith
firm name


Marshall
county well located

LANDOWNER:	description of formations encountered	from	to
Milligan Victoria, Miss. (mailing address)			
WELL LOCATION: sec. 4 T. 1 N. R. 4 E. 10 miles N of Victoria (distance) (direction) (nearest town)			
WELL PURPOSE: None (home, irrigation, municipal, industrial)			
WELL COMPLETION DATA: (1) diameter (inches) 4 (2) total depth (feet) 165 (3) static water level (feet) 100 below top of ground. (4) casing 4" plastic, 165' (material) (depth) (size) if telescope see back. (5) screen 20' length, 145' depth to top (length) (depth to top) 4" plastic (size) (material) (6) pump 1/2 HP, 10 (HP) (yield gpm) 1/2 HP (type power) (7) electric log no (yes or no) (organization running log) (8) how well bottom plugged plugged			
DRILLERS REMARKS: good drilling			

AUG 27 1969
MISSISSIPPI
STATE BOARD OF WATER COMMISSIONERS

If well telescopes please sketch and show depths.

GROUND LEVEL

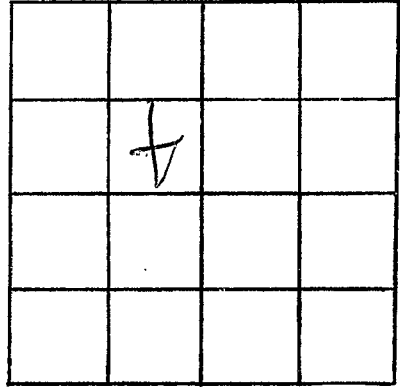

SECTION 4

Please indicate well location X.

ADDITIONAL INFORMATION

If more than one screen, show locations of each on sketch.