

Marshall  
A9  
8-21-69

MISSISSIPPI  
BOARD OF WATER COMMISSIONERS  
416 North State Street  
Jackson, Mississippi 39201

CODED

WATER WELL DRILLERS LOG

Aug 21, 1969 R.L. Carpenter Marshall  
date well completed firm name county well located

LANDOWNER: Roger Salmon  
Collierville R.F.D.  
Tenn.  
(mailing address)

description of formations encountered	from	to
Surface Soil	0	16
med Red Sand	16	49
White Fine Sand	49	68
White Clay	68	74
med white sand	74	90
White coarse sand	90	120

WELL LOCATION:  
sec. 22 T. 1 N. R. 4 E.  
2 1/2 miles North of Cayce  
(distance) (direction) (nearest town)

WELL PURPOSE: Farm  
(home, irrigation, municipal, industrial)

WELL COMPLETION DATA:

(1) diameter (inches) 4 in.  
(2) total depth (feet) 120  
(3) static water level (feet) 92 below top of ground.  
(4) casing (Plastic) 114 ft. (material) (depth)  
(size) If telescope see back.  
(5) screen 6 ft. 114 ft. (length) (depth to top)  
4 in. Plastic & Gravel (size) (material)  
(6) pump 1-HP 20 (HP) (yield gpm)  
Elec. (type power)  
(7) electric log No. (yes or no)  
(organization running log)  
(8) how well bottom plugged Plastic plug

CODED

MAR 10 1970

DRILLERS REMARKS:


MISS. BD. OF  
WATER COMM.

If well telescopes please sketch and show depths.

GROUND LEVEL

R4W

T15

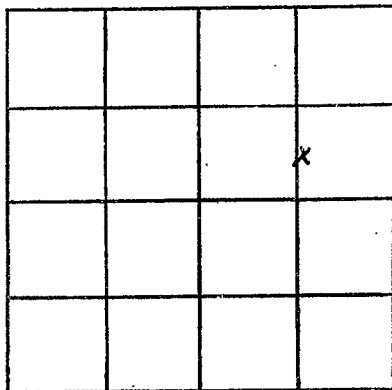

SECTION 22

Please indicate well location X.

ADDITIONAL INFORMATION

If more than one screen, show locations of each on sketch.