

Marshall
A 10
2-6-70

MISSISSIPPI
BOARD OF WATER COMMISSIONERS
416 North State Street
Jackson, Mississippi 39201

CODED

WATER WELL DRILLERS LOG

Feb. 6 1970 R. L. Carpenter Marshall
date well completed firm name county well located

LANDOWNER: Roulon R. Wiggins
87 N. Belvid. Blvd.
Memphis, Tenn.
(mailing address)

description of formations encountered	from to	
Surface Soil	0	15
Coarse white sand	15	47
Fine white sand	47	90
White clay	90	102
Med. Fine white sand	102	138
White coarse sand	138	170

WELL LOCATION:
sec. 23 T. 1 N. R. 4 E.
4 miles West of Mt. Pleasant
(distance) (direction) (nearest town)

WELL PURPOSE: Farm
(home, irrigation, municipal, industrial)

WELL COMPLETION DATA:

(1) diameter (inches) 4 in.
(2) total depth (feet) 170 ft.
(3) static water level (feet) 110 below top of ground.
(4) casing Plastic, 158 ft. (material) (depth)
(size) if telescope see back.
(5) screen 12 ft., 158 ft. (length) (depth to top)
4 in. Plastic & Gravel (size) (material)
(6) pump 1/2 HP, 25 (yield gpm)
Elec. (type power)
(7) electric log no (yes or no)
(organization running log) Plastic Plug
(8) how well bottom plugged

CODED

MAR 10 1970


MISS. BD. OF
WATER COMM.

DRILLERS REMARKS:

If well telescopes please sketch and show depths.

GROUND LEVEL

R 4 W

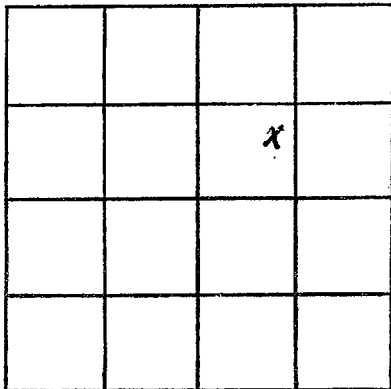

SECTION 23

Please indicate well location X.

ADDITIONAL INFORMATION

If more than one screen, show locations of each on sketch.