

Marshall
 9-17-70
 -A11

MISSISSIPPI
 BOARD OF WATER COMMISSIONERS
 416 North State Street
 Jackson, Mississippi 39201

CODED

WATER WELL DRILLERS LOG

9-17 19 70 Robert W. Wilson Marshall
 date well completed firm name county well located

LANDOWNER: J. E. Hilliard
 R#2
 Collierville, Tenn.
 (mailing address)

| description of formations encountered | from | to |
|---------------------------------------|------|-----|
| Red Clay Red sand | 0 | 20 |
| Red Sand | 20 | 40 |
| Rock White Clay Red sand | 40 | 60 |
| Red sand White Clay white sand | 60 | 80 |
| White sand | 80 | 170 |

WELL LOCATION:
 sec. 33 T-1 N R-4 E
 (distance) miles (direction) of (nearest town)

WELL PURPOSE:
 (home, irrigation, municipal, industrial)

WELL COMPLETION DATA:

- (1) diameter (inches) 4
- (2) total depth (feet) 170
- (3) static water level (feet) 80 below top of ground.
- (4) casing Plastic 150 (material) (depth)
 4 (size) if telescope see back.
- (5) screen 20 150 (length) (depth to top)
 4 Gravel Pack (size) (material)
- (6) pump 5 90 (HP) (yield gpm)
 Electric (type power)
- (7) electric log (yes or no)

(organization running log)

(8) how well bottom plugged
 Plastic Cap

DRILLERS REMARKS:


CODED

SEP 24 1970

MISS. BD OF WATER COMMISSIONERS

If well telescopes please sketch and show depths.

GROUND LEVEL

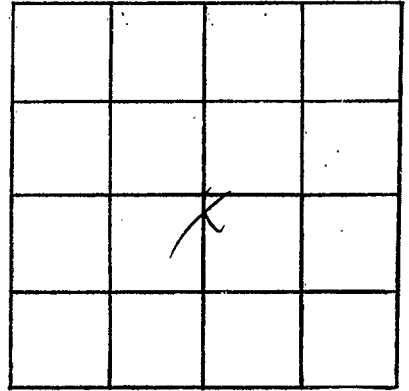

SECTION _____

Please indicate well location X.

ADDITIONAL INFORMATION

If more than one screen,
show locations of each on sketch.