

MISSISSIPPI
BOARD OF WATER COMMISSIONERS
416 North State Street
Jackson, Mississippi 39201

CODED

WATER WELL DRILLERS LOG

Marshall
A 12
6-1-70

June 1 1970 R. L. Carpenter Marshall
date well completed firm name county well located

LANDOWNER: <u>Richard Carington</u> <u>Cayce, Miss.</u> (mailing address)	description of formations encountered	from	to
	<u>Surface Soil</u>	<u>0</u>	<u>18</u>
	<u>Med Red Sand</u>	<u>18</u>	<u>53</u>
WELL LOCATION: sec. <u>34</u> T- <u>1</u> N R- <u>4</u> E <u>1/2</u> miles <u>East</u> of <u>Cayce</u> (distance) (direction) (nearest town)	<u>Med & Fine white Sand</u>	<u>53</u>	<u>86</u>
	<u>Med white Sand</u>	<u>86</u>	<u>108</u>
	<u>White Clay</u>	<u>108</u>	<u>115</u>
WELL PURPOSE: <u>Rainy</u> (home, irrigation, municipal, industrial)	<u>White Fine Sand</u>	<u>115</u>	<u>135</u>
WELL COMPLETION DATA: (1) diameter (inches) <u>4</u>	<u>White coarse sand</u>	<u>135</u>	<u>160</u>
(2) total depth (feet) <u>160</u>			
(3) static water level (feet) <u>95</u> below above top of ground.			
(4) casing <u>Plastic</u> , <u>154 ft.</u> (material) (depth)			
(size) if telescope see back.			
(5) screen <u>6 ft</u> , <u>154 ft.</u> (length) (depth to top)			
<u>1/2 in</u> , <u>Plastic & Sand</u> (size) (material)			
(6) pump <u>1</u> <u>20</u> (HP) (yield gpm)			
<u>Elec.</u> (type power)			
(7) electric log <u>no</u> (yes or no)			
(organization running log)			
(8) how well bottom plugged <u>Plastic cap</u>			
DRILLERS REMARKS:			

CODED


JUL 13 1970

MISS. BD. OF
WATER COM.

If well telescopes please sketch and show depths.

GROUND LEVEL

R 4 W

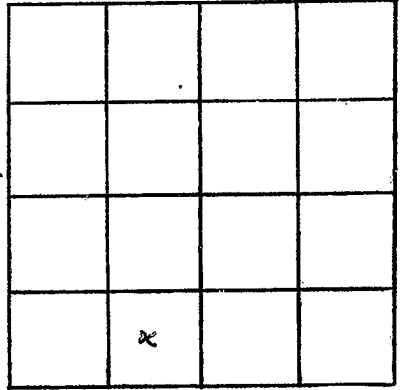

SECTION 34

Please indicate well location X.

ADDITIONAL INFORMATION

If more than one screen, show locations of each on sketch.