

**CODED**

MISSISSIPPI  
BOARD OF WATER COMMISSIONERS

416 North State Street  
Jackson, Mississippi 39201

ltm 7-3-70  
ltm 7/13/70  
before Royal  
Aug 18-70  
Marshall

WATER WELL DRILLERS LOG

*Fishes Drilling*  
firm name

county well located

MARSHALL  
A 13  
6-16-70

10-16-70  
date well completed

LANDOWNER: *Albert Taylor*

*St. 2 Box 4880*

*Collierville Tenn*  
(mailing address)

WELL LOCATION:

sec. 22 T 1 N 4 E  
S W  
5 miles S.E. of *Collierville*  
(distance) (direction) (nearest town)

WELL PURPOSE: *Home*  
(home, irrigation, municipal, industrial)

WELL COMPLETION DATA:

- (1) diameter (inches) 4"
- (2) total depth (feet) 95
- (3) static water level (feet) 74 below above  
top of ground.
- (4) casing Plastic, 75  
(material) (depth)  
(size) if telescope see back.
- (5) screen 10, 85  
(length) (depth to top)  
4", plastic  
(size) (material)
- (6) pump 1/2, 12  
(HP) (yield gpm)  
220  
(type power)
- (7) electric log no  
(yes or no)  
(organization running log)
- (8) how well bottom plugged sealed

description of formations encountered

from

to

clay	0	9-6
sand	9-6	50
clay	50	51
shale	50	59
clay	59	62
sand	62	95

**CODED**


2 1970

MISS:BD. OF  
WATER COMM.

DRILLERS REMARKS:

If well telescopes please sketch and show depths.

GROUND LEVEL

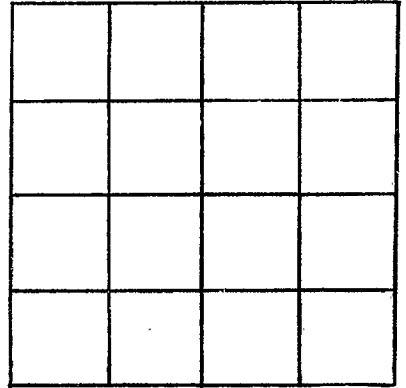

SECTION \_\_\_\_\_

Please indicate well location X.

ADDITIONAL INFORMATION

If more than one screen, show locations of each on sketch.