

**MARSHALL**  
**A-15**  
**4-12-71**

MISSISSIPPI  
 BOARD OF WATER COMMISSIONERS  
 416 North State Street  
 Jackson, Mississippi 39201

WATER WELL DRILLERS LOG

April 12 1971 R. L. Carpenter Marshall  
 date well completed firm name county well located

LANDOWNER: J. R. Hubbert  
 Barton, Miss.  
 RFD  
 (mailing address)

description of formations encountered	from	to
Surface Soil	0	24
Red coarse sand & fine gravel	24	38
white clay	38	60
pebb white sand	60	105
Fine white sand	105	160
Coarse white sand	160	180

WELL LOCATION:  
 sec. 27 T-1 N R-5 E  
 S W  
 1 1/2 miles west of Barton  
 (distance) (direction) (nearest town)

WELL PURPOSE: Home  
 (home, irrigation, municipal, industrial)

- WELL COMPLETION DATA:
- (1) diameter (inches) 4
  - (2) total depth (feet) 180
  - (3) static water level (feet) 97 below top of ground.
  - (4) casing Plastic, 174 ft. (material) (depth)  
 (size) if telescope see back.
  - (5) screen 6 ft., 174 ft. (length) (depth to top)  
 1/2 Plastic & Gravel (size) (material)
  - (6) pump 3/4 10 (HP) (yield gpm)  
 Elec. (type power)
  - (7) electric log No (yes or no)

(organization running log)  
 (8) how well bottom plugged Plastic cap


SEP 2 1971

DRILLERS REMARKS:

MISS. RD. OF  
 WATER COM.

If well telescopes please sketch and show depths.

GROUND LEVEL

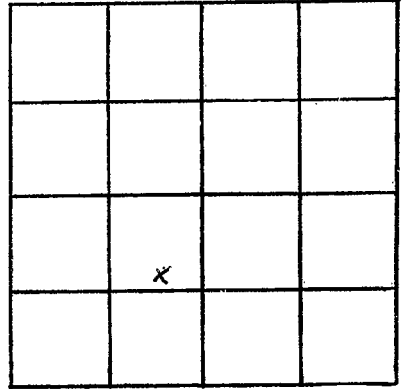

SECTION 27

Please indicate well location X.

ADDITIONAL INFORMATION

If more than one screen,  
show locations of each on sketch.