

A 18
7-66

WATER WELL DRILLERS LOG

CODED

Date: July 18, 1966, Driller: Larry Carpenter County: Marshall
(Name)

(1) Owner of Land: CAROL Joyner
RFD (Name)
COLLIERVILLE, TENN, RFD
(Address)

(2) Location: 1/4, 1/4, Sec. 31 T15R4W
2 miles West, of Cooper, Miss
(distance) (direction) (Nearest Town)

(3) Topography: Hilly
(Hilly) (Flat) (Level)

(4) Purpose of Well: Resident
(Domestic Irrigation
Municipal, Industrial, Other)

Description & Color of Materials Sand, Clay, Red Clay, Shell, etc.	Thick- ness Feet	Depth Feet
Surface soil	16	16
Fine red sand from 16 to 26 ft.	10	26
White coarse sand from 26 to 97 ft.	71	97
hard rock from 97 to 98 ft.	1	98

Information upon completion of well:

(1) Diameter 4 inches.

(2) Total Depth 157 feet.

(3) Water Level 95 feet below top of ground.

(4) Cased to 150, Size 4 in.

(5) Screen: Size 4 in., Length 7 ft.

(6) Were any formations sealed against pollution?
no


Blue mud from 98 to 136 ft.	38	136
Rock from 136 to 136 1/2 ft.	1/2	136 1/2
White sand from 136 1/2 to 157 ft.	20 1/2	157

CODED

If YES depth of formation _____

Why _____

Drillers Remarks: _____

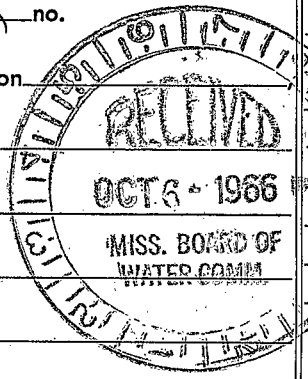

This Well is located
in Mississippi

(Use Back Side)

Well No.

0000

Faint, illegible text scattered across the page, possibly bleed-through from the reverse side.