

MISSISSIPPI
BOARD OF WATER COMMISSIONERS
416 North State Street
Jackson, Mississippi 39201

WATER WELL DRILLERS LOG

CODED

Marshall
A22
1-67

Jan 27 1967 Thorpe Well Supply Marshall
date well completed firm name county well located

LANDOWNER: Viola Wooden

Collierville, TENN

(mailing address)

WELL LOCATION:

sec. 22 T. 1 N. R. 4 E. on Hwy 72
3 miles SOUTH EAST of Collierville
(distance) (direction) (nearest town)

WELL PURPOSE: Home
(home, irrigation, municipal, industrial)

WELL COMPLETION DATA:


- (1) diameter (inches) 4"
- (2) total depth (feet) 152 1/2'
- (3) static water level (feet) 90 ^{below}/_{above} top of ground.
- (4) casing PVC 152 1/2'
(material) (depth)
4"
(size) if telescope see back.
- (5) screen 4' 148
(length) (depth to top)
4" PVC + Sand
(size) (material)
- (6) pump 1/2 10
(HP) (yield gpm)
230 VOLTS
(type power)
- (7) electric log NO
(yes or no)
(organization running log)
- (8) how well bottom plugged
4" CAP

description of formations encountered

from to

Top Soil	0	5
White Clay	5	25
White Clay & Sand	25	35
White coarse sand	35	55
White Clay	55	65
White Clay & Sand mix	65	75
White Sand	75	115
White Fine Sand & Clay	115	135
White Fine Sand	135	145
White coarse sand	145	155

CODED

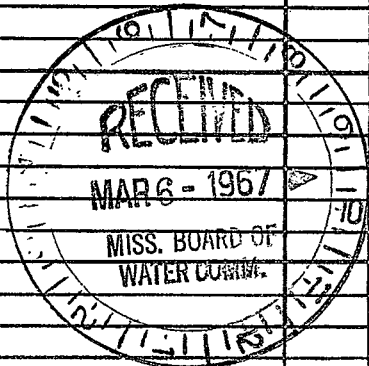

DRILLERS REMARKS:

If well telescopes please sketch and show depths.

GROUND LEVEL

	X		

SECTION 22

Please indicate well location X.

ADDITIONAL INFORMATION

70
88
7
-585/9
91

If more than one screen, show locations of each on sketch.