

Marshall
A25
3-67

MISSISSIPPI BOARD OF WATER COMMISSIONERS

WATER WELL DRILLERS LOG

CODED

Date: May 21, 1967, Driller: Larry Carpenter County Marshall
(When well drilled) (Name) (Where well is located)

(1) Owner of Land: Roland Wiggs
(Name)
Memphis, Tenn.
(Address)

(2) Location: 1/4, 1/4, Sec. 23 T15 R4 W
3 1/2 miles northeast of Mt. Pleasant
(distance) (direction) (Nearest Town)

(3) Topography: Hilly
(Hilly) (Flat) (Level)

(4) Purpose of Well: Farm
(Domestic Irrigation, Municipal, Industrial, Other)

| Description & Color of Materials Sand, Clay, Red Clay, Shell, etc. | Thick- ness Feet | Depth Feet |
|-----------------------------------------------------------------------|------------------------|---------------|
| <u>Surface Soil</u> | <u>16</u> | <u>16</u> |
| <u>Coarse Red Sand</u> | <u>18</u> | <u>34</u> |
| <u>White Clay</u> | <u>2</u> | <u>36</u> |
| <u>Medium white sand</u> | <u>6</u> | <u>91</u> |
| <u>Coarse white sand</u> | <u>11</u> | <u>116</u> |

Information upon completion of well:

(1) Diameter 4 inches.

(2) Total Depth 116 feet.

(3) Water Level 83 feet below top of ground.

(4) Cased to 109 ft. Size 4 in.

(5) Screen: Size 4 in., Length 7 ft.

(6) Were any formations sealed against pollution?
_____ yes, X no.

This well located in Miss.

If YES depth of formation _____


Why _____

Drillers Remarks: _____

Yield in gpm: Bucket Well

Size pump: _____

Type power: _____

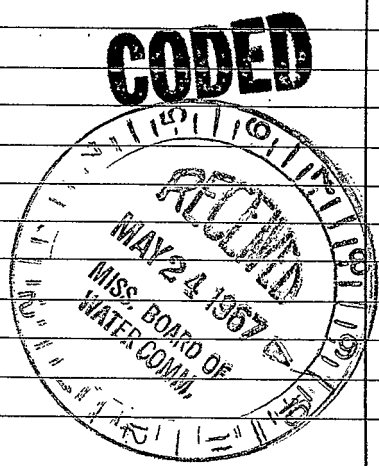

R4W

715



Sec. 23