

Marshall
A26
4-67

MISSISSIPPI
BOARD OF WATER COMMISSIONERS
416 North State Street
Jackson, Mississippi 39201

WATER WELL DRILLERS LOG **CODED**

April 5 1967 R. L. Carpenter Marshall
date well completed firm name county well located

LANDOWNER:
New Sheno Church
Collierville, Tenn.
(mailing address)

description of formations encountered	from	to
Surface Soil		22
White Coarse Sand	22	53
Yellow & white clay	53	85
White Coarse Sand	85	110


WELL LOCATION:
sec. 22 T-1 N R-4 E
2 miles North of Coace
(distance) (direction) (nearest town)

WELL PURPOSE: Church
(home, irrigation, municipal, industrial)

- WELL COMPLETION DATA:
- (1) diameter (inches) 4
 - (2) total depth (feet) 110
 - (3) static water level (feet) 80 below above top of ground.
 - (4) casing Plastic, 104,
(material) (depth)
 if telescope see back.
(size)
 - (5) screen 6 ft., 104 ft
(length) (depth to top)
4 in., Plastic & Haul
(size) (material)
 - (6) pump 1/2 10
(HP) (yield gpm)
Elec.
(type power)
 - (7) electric log no
(yes or no)

(organization running log)
 - (8) how well bottom plugged Plastic Plug

This **CODED**
located in Miss.

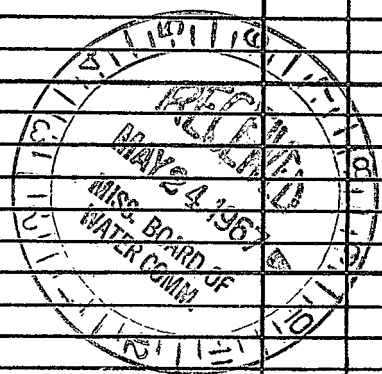

DRILLERS REMARKS:

If well telescopes please sketch and show depths.

GROUND LEVEL

R 4 W

715

		x	

SECTION 22

Please indicate well location X.

ADDITIONAL INFORMATION

If more than one screen,
show locations of each on sketch.