

Marshall
A 27
8-67

MISSISSIPPI
BOARD OF WATER COMMISSIONERS
416 North State Street
Jackson, Mississippi 39201

WATER WELL DRILLERS LOG CODED

Aug. 8 1967 R. L. Carpenter Marshall
date well completed firm name county well located

LANDOWNER: Mrs. Walter L. L...
Callierville RFD
Term.
(mailing address)

WELL LOCATION:
sec. 26 T. 1 N. R. 4 E
2 miles Northwest, Cayce, Miss.
(distance) (direction) (nearest town)


WELL PURPOSE: Home
(home, irrigation, municipal, industrial)

WELL COMPLETION DATA:

- (1) diameter (inches) 4 in.
- (2) total depth (feet) 170 ft.
- (3) static water level (feet) 120 below top of ground.
- (4) casing Plastic, 164, (material) (depth)
If telescope see back. (size)
- (5) screen 6 ft., 164 ft. (length) (depth to top)
4 in., Plastic & Gravel (size) (material)
- (6) pump 3/4 HP, 12 (yield gpm)
Elec. (type power)
- (7) electric log no (yes or no)
(organization running log)
- (8) how well bottom plugged Plastic Plug

description of formations encountered	from	to
Surface Soil	0	17
Coarse Red Sand	17	37
Coarse white sand	37	86
White Clay	86	95
White Coarse sand	95	170

CODED

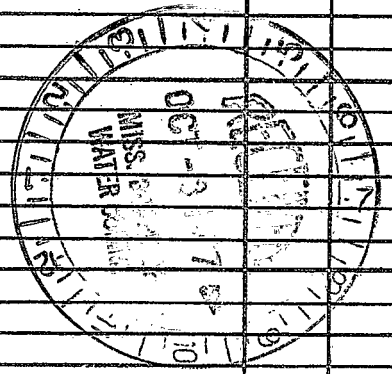

DRILLERS REMARKS:

If well telescopes please sketch and show depths.

GROUND LEVEL

R 4 W

T 15

		X	

SECTION 26

Please indicate well location X.

ADDITIONAL INFORMATION

~~S.W. N.E.~~

If more than one screen, show locations of each on sketch.