

Marshall
A 28
9-67

MISSISSIPPI
BOARD OF WATER COMMISSIONERS
416 North State Street
Jackson, Mississippi 39201

CODED

WATER WELL DRILLERS LOG

Sept. 27 1967 R. L. Caspenta Marshall
date well completed firm name county well located

LANDOWNER: Billy Janison
Collieville, R.F.D.
Term.
(mailing address)

WELL LOCATION:
sec. 21 T 1 N R 4 E
2 1/2 miles north of Coyce
(distance) (direction) (nearest town)

WELL PURPOSE: Farm
(home, irrigation, municipal, industrial)

WELL COMPLETION DATA:

- (1) diameter (inches) 2
- (2) total depth (feet) 110
- (3) static water level (feet) 80 below above top of ground.
- (4) casing Steel, 106,
(material) (depth)
2 If telescope see back.
(size)
- (5) screen 4 ft., 106
(length) (depth to top)
2 in., Stainless Steel
(size) (material)
Am. Stroke Rod Pump
- (6) pump 1 H.P. motor 3
(HP) (yield gpm)
Elec.
(type power)
- (7) electric log No
(yes or no)
(organization running log)
- (8) how well bottom plugged Steel Plug

description of formations encountered	from	to
<u>Surface Soil</u>	<u>0</u>	<u>17</u>
<u>Coarse Red sand</u>	<u>17</u>	<u>50</u>
<u>White Fine sand</u>	<u>50</u>	<u>61</u>
<u>White Clay</u>	<u>61</u>	<u>68</u>
<u>White Coarse sand</u>	<u>68</u>	<u>110</u>

CODED




DRILLERS REMARKS:

If well telescopes please sketch and show depths.

R4W

GROUND LEVEL

T15

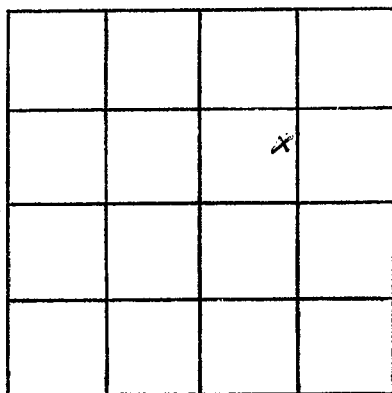

SECTION 21

Please indicate well location X.

ADDITIONAL INFORMATION

If more than one screen, show locations of each on sketch.