

Marshall  
A29  
5-68

MISSISSIPPI  
BOARD OF WATER COMMISSIONERS  
416 North State Street  
Jackson, Mississippi 39201

**CODED**

WATER WELL DRILLERS LOG

5-18 1968 Lead Well Co Marshall  
date well completed firm name county well located

LANDOWNER:  
Frank Davis  
Calloway, Tenn  
(mailing address)

description of formations encountered	from	to
Surface Clay	0	15
Gravel	15	25
Red Sand + clay	25	42
Rock	42	43
Fine Sand + clay	43	110
Coarse White Sand	110	132

WELL LOCATION:  
sec. 26 T. 1 N. R. 5 E  
Behrens Stone at Barton  
miles of miss  
(distance) (direction) (nearest town)

WELL PURPOSE: Home  
(home, irrigation, municipal, industrial)

WELL COMPLETION DATA:

(1) diameter (inches) 4

(2) total depth (feet) 132

(3) static water level (feet) 90 below above top of ground.

(4) casing Plastic, 126 (material), (depth),  
(size) if telescope see back.

(5) screen 6' 126 (length), (depth to top)  
4" Plastic (size), (material)

(6) pump 3/4 15 (HP), (yield gpm)  
Elec (type power)

(7) electric log (yes or no)  
(organization running log)

(8) how well bottom plugged Plastic Plug


**CODED**

MISS. BOARD OF WATER COMM.

DRILLERS REMARKS:

If well telescopes please  
sketch and show depths:

GROUND LEVEL

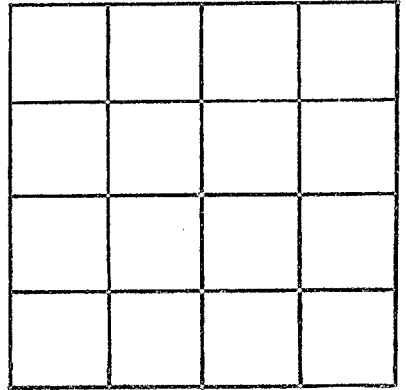

SECTION \_\_\_\_\_

Please indicate well location X.

ADDITIONAL INFORMATION

If more than one screen,  
show locations of each on sketch.