

MISSISSIPPI  
BOARD OF WATER COMMISSIONERS  
416 North State Street  
Jackson, Mississippi 39201

**CODED**

WATER WELL DRILLERS LOG

MARSHALL  
A30  
10-67

10-6 date well completed 1967 Leake Well Co. firm name Marshall county well located

LANDOWNER:

Marion Blount

Collierville, Tenn  
(mailing address)

WELL LOCATION:

sec 36 T 1 N R 5 E  
6 miles South of Collierville  
(distance) (direction) (nearest town)

WELL PURPOSE: home  
(home, irrigation, municipal, industrial)

WELL COMPLETION DATA:


- (1) diameter (inches) 4"
- (2) total depth (feet) 140
- (3) static water level (feet) 92 below top of ground.
- (4) casing Plastic, 134 (material) (depth)  
If telescope see back. (size)
- (5) screen 6' 134 (length) (depth to top)  
4" Plastic (size) (material)
- (6) pump 3/4 15 (HP) (yield gpm)  
Elec. (type power)
- (7) electric log (yes or no)  
(organization running log)
- (8) how well bottom plugged Plastic

description of formations encountered

from to

Surface Clay	1	20
Sand + gravel	20	38
Blue Clay	38	75
Fine Sand & Clay	75	110
Fine sand	110	127
Coarse Sand	127	140

**CODED  
CODED**

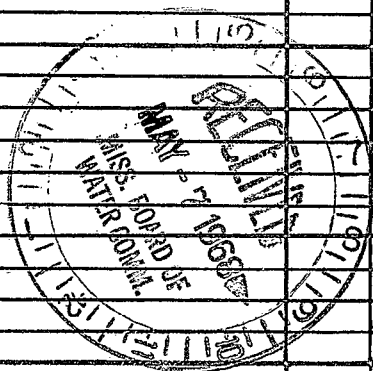


DRILLERS REMARKS:

Good Water Supply

If well telescopes please sketch and show depths.

GROUND LEVEL

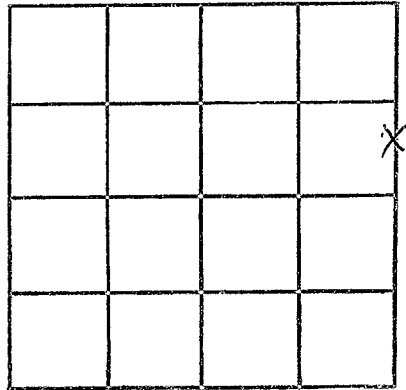

SECTION 35

Please indicate well location X.

ADDITIONAL INFORMATION

If more than one screen, show locations of each on sketch.