

MARSHALL
A 32
1-11-72

MISSISSIPPI
 BOARD OF WATER COMMISSIONERS
 416 North State Street
 Jackson, Mississippi 39201

CODED

WATER WELL DRILLERS LOG

Jan 11 1972 R. L. Carpenter Marshall
 date well completed firm name county well located

LANDOWNER:	description of formations encountered	from	to
<u>Billy Ray</u> <u>Collinsville, Tenn.</u> <u>RFD</u> (mailing address)	<u>Surface Soil</u>	<u>0</u>	<u>15</u>
	<u>Med Red Sand</u>	<u>15</u>	<u>46</u>
WELL LOCATION: sec <u>22</u> T <u>1</u> N R <u>4</u> E <u>S</u> <u>W</u>	<u>Med. white sand</u>	<u>46</u>	<u>73</u>
<u>2</u> miles <u>North</u> of <u>Coyce</u> (distance) (direction) (nearest town)	<u>white clay</u>	<u>73</u>	<u>83</u>
WELL PURPOSE: <u>Home</u> (home, irrigation, municipal, industrial)	<u>Med. & fine white sand</u>	<u>83</u>	<u>110</u>
WELL COMPLETION DATA:	<u>Coarse white sand</u>	<u>110</u>	<u>148</u>
(1) diameter (inches) <u>4</u>			
(2) total depth (feet) <u>148</u>			
(3) static water level (feet) <u>75</u> below top of ground.			
(4) casing <u>Plastic</u> , <u>138</u> ft. (material) (depth)			
(size) If telescope see back.			
(5) screen <u>10</u> , <u>138 ft</u> (length) (depth to top)			
<u>4 in</u> , <u>Plastic & gravel</u> (size) (material)			
(6) pump <u>3/4</u> , <u>18</u> (HP) (yield gpm)			
<u>Elec.</u> (type power)			
(7) electric log <u>No.</u> (yes or no)			
(organization running log)			
(8) how well bottom plugged <u>Plastic clay</u>			
DRILLERS REMARKS:			


CODED

NOV 4 1972

MISS. BD. OF
 WATER COM.

If well telescopes please sketch and show depths.

GROUND LEVEL

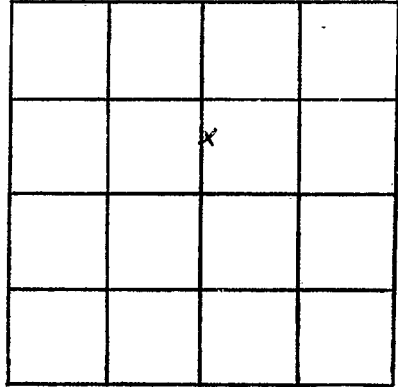

SECTION 22

Please indicate well location X.

ADDITIONAL INFORMATION

If more than one screen,
show locations of each on sketch.