

MARSHALL
A41
4-8-73

MISSISSIPPI
 BOARD OF WATER COMMISSIONERS
 416 North State Street
 Jackson, Mississippi 39201

CODED

WATER WELL DRILLERS LOG

4-8-73 1973 Bob Hill Marshall
 date well completed firm name county well located

LANDOWNER:

Earnest Walker

Barton - miss.
 (mailing address)

WELL LOCATION:

sec. 34 T. 1 N. R. 5 E.
1 3/4 miles West of Barton
 (distance) (direction) (nearest town)

WELL PURPOSE:

None
 (home, irrigation, municipal, industrial)

WELL COMPLETION DATA:

- (1) diameter (inches) 4
- (2) total depth (feet) 175
- (3) static water level (feet) 100 below above top of ground.
- (4) casing Plastic, 175
 (material) (depth)
 (size) if telescope see back.
- (5) screen 20, 155
 (length) (depth to top)
4, Plastic
 (size) (material)
- (6) pump 1/2 10
 (HP) (yield gpm)
Elec.
 (type power)
- (7) electric log No
 (yes or no)
 (organization running log)
- (8) how well bottom plugged plugged

description of formations encountered

	from	to
<u>clay silt</u>		<u>18</u>
<u>gravel</u>	<u>18</u>	<u>40</u>
<u>black clay</u>	<u>40</u>	<u>75</u>
<u>streaks of clay & sand 80% sand</u>	<u>75</u>	<u>145</u>
<u>white sand</u>	<u>145</u>	<u>175</u>


CODED

DRILLERS REMARKS:

APR 11 1973

If well telescopes please sketch and show depths.

GROUND LEVEL

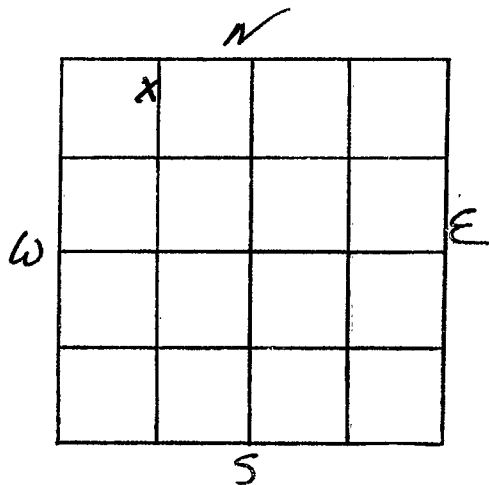

SECTION 34

Please indicate well location X.

ADDITIONAL INFORMATION

If more than one screen,
show locations of each on sketch.