

MARSHALL
A 42
4-2-73

MISSISSIPPI
 BOARD OF WATER COMMISSIONERS
 416 North State Street
 Jackson, Mississippi 39201
WATER WELL DRILLERS LOG

CODED

4-3-73 date well completed Bob Smith firm name Marshall county well located

LANDOWNER: Angel S. Hill
Barton - Miss.
 (mailing address)

WELL LOCATION:
 sec. 34 T. 1 N. R. 5 E.
1 3/4 miles West of Barton
 (distance) (direction) (nearest town)

WELL PURPOSE: None
 (home, irrigation, municipal, industrial)

WELL COMPLETION DATA:
 (1) diameter (inches) 4
 (2) total depth (feet) 170
 (3) static water level (feet) 84 below above top of ground.
 (4) casing Plastic 170
 (material) (depth)
 (size) If telescope see back.
 (5) screen 20 150
 (length) (depth to top)
4 Plastic
 (size) (material)
 (6) pump 1/2 10
 (HP) (yield gpm)
Elec.
 (type power)
 (7) electric log no
 (yes or no)

description of formations encountered	from	to
clay dirt		15
gravel	15	30
blue clay	30	115
Thin sand rock at		115
Coarse sand	115	125
white clay	125	148
white sand	148	170


CODED

DRILLERS REMARKS:

(8) how well bottom plugged plugged

If well telescopes please sketch and show depths.

GROUND LEVEL

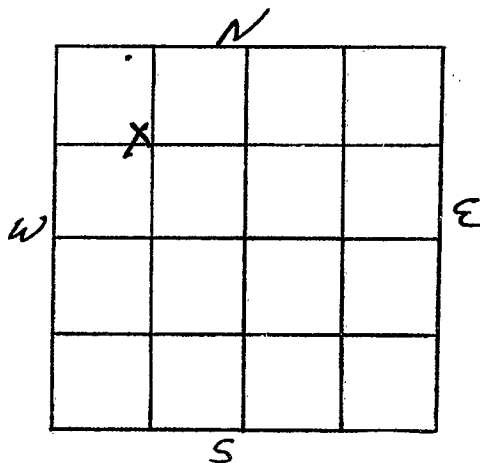

SECTION 34

Please indicate well location X.

ADDITIONAL INFORMATION

If more than one screen, show locations of each on sketch.