

MARSHALL

A 44

8-3-73

MISSISSIPPI BOARD OF WATER COMMISSIONERS  
416 North State Street  
Jackson, Mississippi 39201

CODED

WATER WELL DRILLERS LOG

8-3-73  
date well completed

Bob Smith  
firm name

Marshall  
county well located

LANDOWNER:

Jay Meek

Barton - Min  
(mailing address)

WELL LOCATION:

sec. 34 T 1 N R 5 E  
(S) (W)  
1 1/2 miles WEST of Barton  
(distance) (direction) (nearest town)

description of formations encountered

from

to

clay silt

to

8

gravel

8

20

yellow sand

20

40

white clay

40

70

white sand

70

140

WELL PURPOSE:

None  
(home, irrigation, municipal, industrial)

WELL COMPLETION DATA:

- (1) diameter (inches) 4
- (2) total depth (feet) 140
- (3) static water level (feet) 87 below top of ground.
- (4) casing Plastic, 140  
(material) (depth)

(size) if telescope see back.

- (5) screen 20, 120  
(length) (depth to top)
- 4, Plastic  
(size) (material)

- (6) pump 1/2, 10  
(HP) (yield gpm)

Elec  
(type power)

- (7) electric log No  
(yes or no)

(organization running log)

- (8) how well bottom plugged

DRILLERS REMARKS:


CODED

SEP 27 1973

MISS. BO. OF  
WATER COMMISSIONERS

If well telescopes please sketch and show depths.

GROUND LEVEL

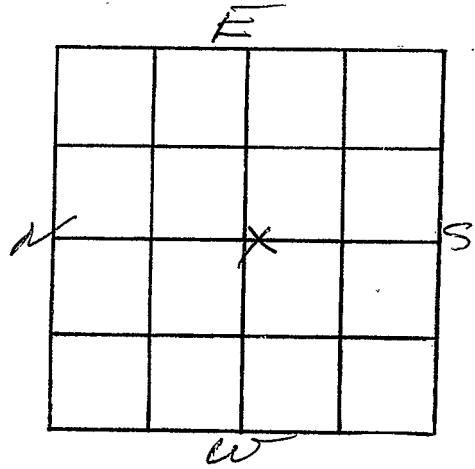

SECTION 34

Please indicate well location X.

ADDITIONAL INFORMATION

If more than one screen, show locations of each on sketch.