

MARSHALL
A45
8-7-73

MISSISSIPPI
BOARD OF WATER COMMISSIONERS
 416 North State Street
 Jackson, Mississippi 39201 **CODED**

WATER WELL DRILLERS LOG

8-7-1973 date well completed Robert W. Wilcox firm name Marshall county well located

LANDOWNER: W. A. Smith
Marshall, Miss
 (mailing address)

description of formations encountered	from	to
Brown clay	0	9
red clay & red sand	9	15
yellow sand	15	22
red sand	22	50
white sand	50	117
white clay	117	125
white sand & red clay	125	147
white clay & sand	147	157
white sand line	157	180
white sand & gravel	180	510

WELL LOCATION:
 sec. 36 T 1 N R 4 E
 (S) (W)
 _____ miles _____ of _____
 (distance) (direction) (nearest town)

WELL PURPOSE:
 (home, irrigation, municipal, industrial)

WELL COMPLETION DATA:

- (1) diameter (inches) 4
- (2) total depth (feet) 210
- (3) static water level (feet) 65 below above top of ground.
- (4) casing _____, _____, _____
 (material) (depth)
 _____ if telescope see back.
 (size)
- (5) screen 8, 200
 (length) (depth to top)
4, gravel packed
 (size) (material)
- (6) pump 1, 15
 (HP) (yield gpm)
electric
 (type power)
- (7) electric log _____
 (yes or no)

 (organization running log)
- (8) how well bottom plugged 4"
plastic cap


DRILLERS REMARKS: _____

CODED

FEB 1974
 MISS. Bd. OF WATER COMMISSIONERS

If well telescopes please sketch and show depths.

GROUND LEVEL

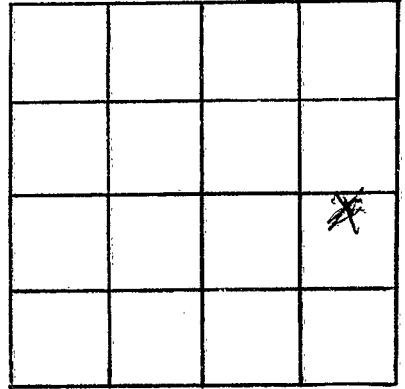

SECTION 36

Please indicate well location X.

ADDITIONAL INFORMATION

If more than one screen,
show locations of each on sketch.