

**MARSHALL**  
**A 46**  
**2-13-74**

MISSISSIPPI  
 BOARD OF WATER COMMISSIONERS  
 416 North State Street JACKSON, MISSISSIPPI 39201 **CODED**

**WATER WELL DRILLERS LOG**

Feb 13 1974 R. L. Cooper Co. Marshall  
 date well completed firm name county well located

LANDOWNER: Wesley Woodson

Collierville, Tenn

RFD

(mailing address)

WELL LOCATION:

sec. 22 T 1 N R 4 E  
3 miles southwest of Cooper  
 (distance) (direction) (nearest town)

WELL PURPOSE: Home  
 (home, irrigation, municipal, industrial)

WELL COMPLETION DATA:

- (1) diameter (inches) 4
- (2) total depth (feet) 118
- (3) static water level (feet) 75 below top of ground.
- (4) casing Plastic, 112 ft.  
 (material) (depth)

         if telescope see back.  
 (size)

- (5) screen 6, 112 ft.  
 (length) (depth to top)  
4 in., Plastic thread  
 (size) (material)

- (6) pump 1/2 8  
 (HP) (yield gpm)

Elec.  
 (type power)

- (7) electric log no  
 (yes or no)

          
 (organization running log)

- (8) how well bottom plugged Plastic cap

DRILLERS REMARKS:

description of formations encountered	from	to
<u>surface soil</u>	<u>0</u>	<u>18</u>
<u>white clay</u>	<u>18</u>	<u>50</u>
<u>med white sand</u>	<u>50</u>	<u>60</u>
<u>white clay</u>	<u>60</u>	<u>91</u>
<u>white coarse sand</u>	<u>91</u>	<u>118</u>


**CODED**

**RECORDED**  
**INDEXED**  
**NOV 12 1974**

MISS. Bd. OF WATER COMMISSIONERS

If well telescopes please sketch and show depths.

GROUND LEVEL

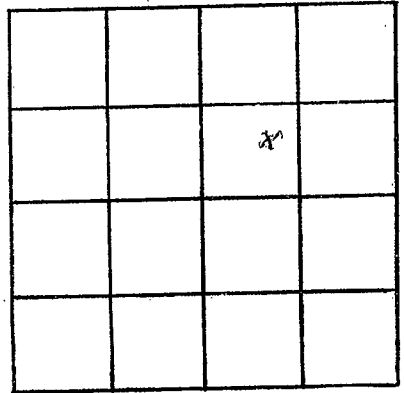

SECTION 22

Please indicate well location X.

ADDITIONAL INFORMATION

If more than one screen, show locations of each on sketch.