

MARSHALL
A47
8-29-73

MISSISSIPPI
 BOARD OF WATER COMMISSIONERS
 416 North State Street
 Jackson, Mississippi 39201

WATER WELL DRILLERS LOG CODED

Aug. 29 1973 R.L. Carpenter Marshall
 date well completed firm name county well located

LANDOWNER: John W. Baringer
4556 Chickasaw Rd.
Memphis, Tenn.
 (mailing address)


description of formations encountered	from	to
Surface Soil	0	18
Med. Brown Sand	18	40
Fire white sand	40	72
White clay	72	80
White coarse sand	80	125

WELL LOCATION:
 sec. 33 T 1 N R 4 E
1 miles West of Coyce
 (distance) (direction) (nearest town)

WELL PURPOSE: Farm
 (home, irrigation, municipal, industrial)

- WELL COMPLETION DATA:
- (1) diameter (inches) 4
 - (2) total depth (feet) 125
 - (3) static water level (feet) 60 below above top of ground.
 - (4) casing Plastic, 119 ft
 (material) (depth)
 (size) If telescope see back.
 - (5) screen 6, 119 ft
 (length) (depth to top)
4 in. Plastic Screen
 (size) (material)
 - (6) pump 1/2, 8
 (HP) (yield gpm)
Elec
 (type power)
 - (7) electric log No.
 (yes or no)
- (organization running log)
- (8) how well bottom plugged Plastic Plug


CODED

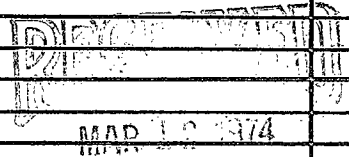

DRILLERS REMARKS:

If well telescopes please sketch and show depths.

GROUND LEVEL

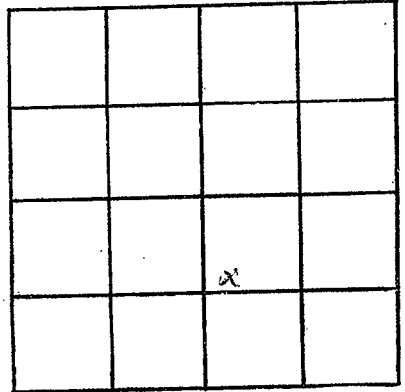

SECTION 33

Please indicate well location X.

ADDITIONAL INFORMATION

If more than one screen, show locations of each on sketch.