

MARSHALL

A 48

9-12-73

MISSISSIPPI
BOARD OF WATER COMMISSIONERS
416 North State Street
Jackson, Mississippi 39201

CODED

WATER WELL DRILLERS LOG

Sept. 12 1973 R. L. Carpenter Marshall
date well completed firm name county well located

LANDOWNER: Roger Wade

Holly Springs,
Miss.
(mailing address)

description of formations
encountered

from

to

Surface Soil

0

20

Dark Mottled Sand

20

52

White Clay

52

60

White Fine Sand

60

75

Coarse White Sand

75

165

WELL LOCATION:

sec 24 T-1 N R-5 E
(S) (W)
1 miles Faith of Barton
(distance) (direction) (nearest town)

WELL PURPOSE:

(home, irrigation, municipal, industrial)

WELL COMPLETION DATA:

- (1) diameter (inches) 4
(2) total depth (feet) 165
(3) static water level (feet) 75 below
top of ground.
(4) casing Plastic, 152 ft.
(material) (depth)

(size) If telescope see back.

- (5) screen 13 ft. 152 ft.
(length) (depth to top)

4 in. Plastic screen
(size) (material)

- (6) pump 2 30
(HP) (yield gpm)

Elec
(type power)

- (7) electric log No.
(yes or no)

(organization running log)

- (8) how well bottom plugged Plaster cap

DRILLERS REMARKS:

CODED


DECK
1973

MAR 12 1974
1115 SEC

MISS. BD. OF WATER COMM

If well telescopes please
sketch and show depths.

GROUND LEVEL

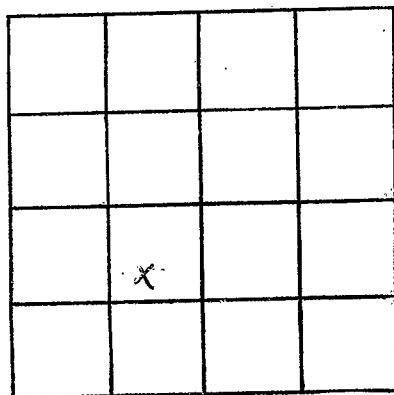

SECTION 24

Please indicate well location X.

ADDITIONAL INFORMATION

If more than one screen,
show locations of each on sketch.