

MARSHALL
A 49
10-4-73

MISSISSIPPI
 BOARD OF WATER COMMISSIONERS
 416 North State Street
 Jackson, Mississippi 39201 **CODED**

WATER WELL DRILLERS LOG

Oct. 4 1973 R. L. Carpenter Marshall
 date well completed firm name county well located

LANDOWNER: Magnolia Mingo
Collinsville, Tenn.
 (mailing address)

description of formations encountered	from	to
<u>Surface Sand</u>	<u>8</u>	<u>18</u>
<u>med white sand</u>	<u>18</u>	<u>40</u>
<u>Coarse White Sand</u>	<u>40</u>	<u>73</u>
<u>White Clay</u>	<u>73</u>	<u>90</u>
<u>Coarse White Sand</u>	<u>90</u>	<u>126</u>

WELL LOCATION:
 sec. 28 T 1 N R 4 E
3 miles Northwest of Coyzee
 (distance) (direction) (nearest town)

WELL PURPOSE: Open
 (home, irrigation, municipal, industrial)



- WELL COMPLETION DATA:
- (1) diameter (inches) 4 in
 - (2) total depth (feet) 120
 - (3) static water level (feet) 86 below above top of ground.
 - (4) casing Plastic, 114 ft.
 (material) (depth)
 (size) If telescope see back.
 - (5) screen 6 ft., 114 ft.
 (length) (depth to top)
4 in., Plastic & Braided
 (size) (material)
 - (6) pump 1/2 8
 (HP) (yield gpm)
2 hp.
 (type power)
 - (7) electric log no.
 (yes or no)
 - (organization running log)
 - (8) how well bottom plugged Plastic Cap

CODED

DRILLERS REMARKS:

If well telescopes please sketch and show depths.

GROUND LEVEL

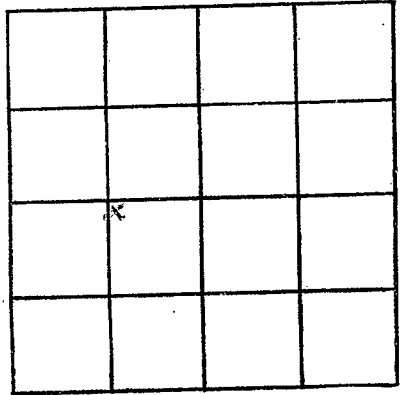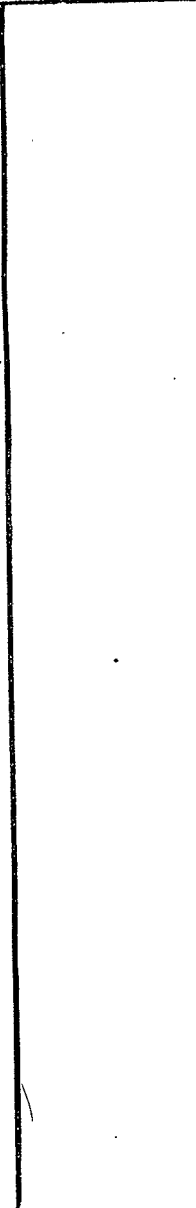

SECTION Z 55

Please indicate well location X.

ADDITIONAL INFORMATION

A series of horizontal lines providing space for entering additional information.

If more than one screen, show locations of each on sketch.