

**MARSHALL**  
**A50**  
**11-12-73**

MISSISSIPPI  
 BOARD OF WATER COMMISSIONERS  
 416 North State Street  
 Jackson, Mississippi 39201

**WATER WELL DRILLERS LOG**

Nov. 12 19 73 R. L. Carpenter Marshall  
 date well completed firm name county well located

LANDOWNER: Tracy Tee Cox  
Colbertville, Tenn.

(mailing address)

WELL LOCATION:

sec. 27T-1N R-5E  
2 1/2 miles Northwest of Benton  
 (distance) (direction) (nearest town)


WELL PURPOSE: Domestic  
 (home, irrigation, municipal, industrial)

WELL COMPLETION DATA:

- (1) diameter (inches) 4
- (2) total depth (feet) 126
- (3) static water level (feet) 6.5 below top of ground.
- (4) casing Plastic, 119 ft.  
 (material) (depth)
- if telescope see back.  
 (size)
- (5) screen 6 ft., 119 ft.  
 (length) (depth to top)
- 1/2 in., Plastic Board  
 (size) (material)
- (6) pump 1/2 8  
 (HP) (yield gpm)
- Electric  
 (type power)
- (7) electric log Yes  
 (yes or no)
- (organization running log)
- (8) how well bottom plugged Plastic Casing

description of formations encountered	from	to
Surface Soil	0	15
med. white sand	15	60
white clay	60	72
med. white sand	72	100
white coarse sand	100	126

CODED

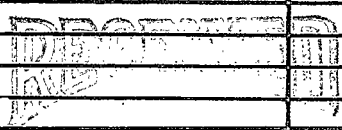


MAR 12 1974

DRILLERS REMARKS:

If well telescopes please sketch and show depths.

GROUND LEVEL

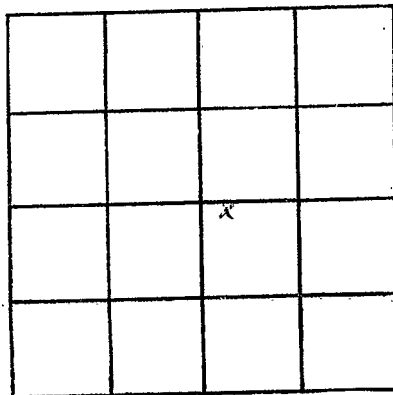

SECTION 27

Please indicate well location X.

ADDITIONAL INFORMATION

If more than one screen, show locations of each on sketch.